



FORM 51 1511700210000 Marshall KANSAS
 Section 13 Township 2 Range 6 E
 Well No. # 1 Holle
 Company Fred Noren et al

Marshall KANSAS
 SEC. 13 TWP. 2 R. 6E ✓
 WELL NO. #1 Holle FARM
 COMPANY Fred Noren et al
 CONTRACTOR

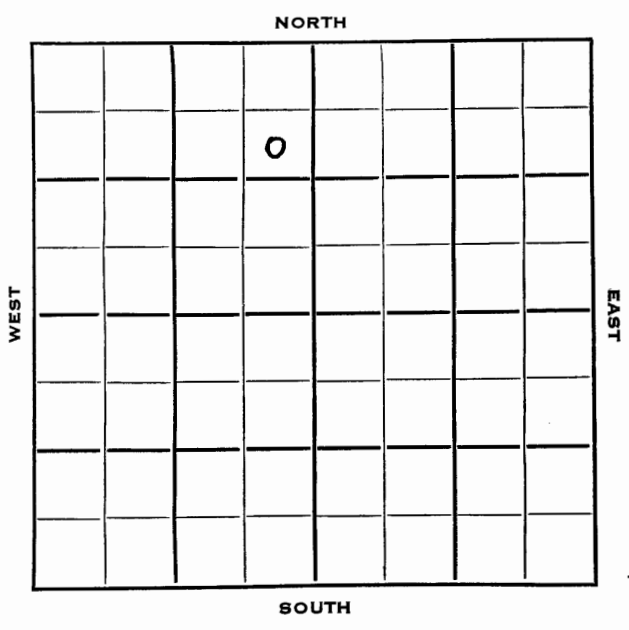

3

Stout
Wildcat
990 Ft. from N. Line
 Ft. from S. Line
330 Ft. from E. Line
 Ft. from W. Line
 SE NE NW

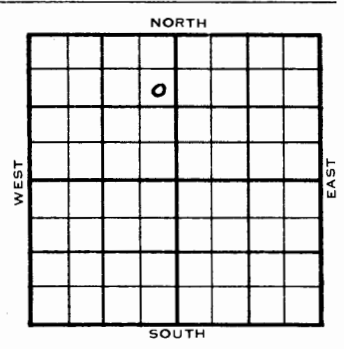

	ELEVATION	REPORT
1953		
11/18 1954 1/6	M I R	Spud 11-29-53 8" @ 74 Hunton 1512' TD 1931' D & A
		ABANDONED

County	Marshall	State	Kansas
Sec.	13 (Blk. Twp.)	2 (Sur. Rge.)	6E Map No.
Operator	Fred Noren et al.		
Well No.	1	Farm	Holle
Elev.	Location SE NE NW		
	990 Ft. From N Line NW		
	330 Ft. From E Line Quarter		
	1st. Report		
	Completion JAN 8 1954		
	Remarks Wildcat		
	Stout - Contr.		
	Spudding Date 11-29-53		

ABANDONED

Drilg. Data

8" @ 74 Hunton 1512 TD 1931

D & A

J. G. McGEHEE

County	Marshall	State	Kansas
Sec.	13 (Blk. Twp.)	2 (Sur. Rge.)	6E Map No.
Operator	Fred Noren et al.		
Well No.	1	Farm	Holle
Elev.	Location SE NE NW		
	990 Ft. From N Line NW		
	330 Ft. From E Line Quarter		
	1st. Report NOV 18 1953		
	Completion		
	Remarks		
	Stout - Contr.		
	Spudding Date		

FIRST

Drilg. Data

Wildcat

M I R

J. G. McGEHEE