


Map No. **KANSAS**Map No. **KANSAS** Sec. 15 Twp. 2 R. 6

Well No. 1 - Funkle Farm

Blaser & Co.

NORTH

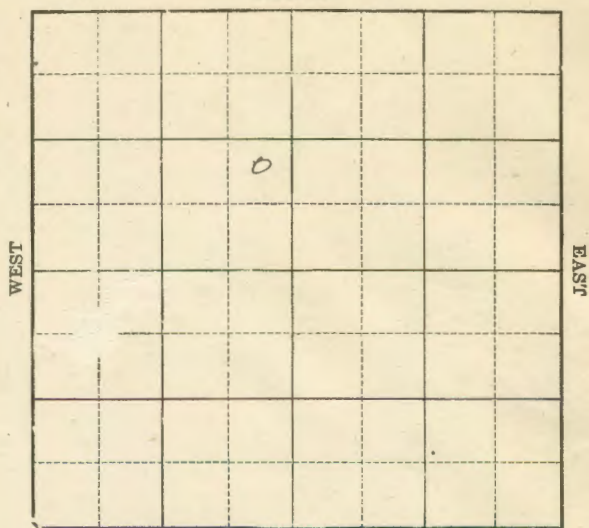

SOUTH

Location _____
Drilling Remarks _____

Rig Up Drilling Remarks

RECORD

Cased _____ in. _____ ft.
 Sand _____
 Gas _____
 Oil _____
 Total Depth _____

PRODUCTION


1st 24 hrs. Nat. _____
1st 24 hrs. after shot _____
Gas _____ cu. ft. _____
Dry Hole _____
Abandoned _____

Map No. KANSAS Sec. 13 Twp. 2 R. 6

Well No. 1 - *Trunkle* Farm

Blaser, et al Company

NORTH

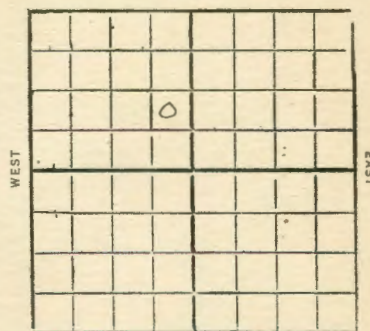

SOUTH

Ft. from N. Line

1020 Ft. from S. Line

250 Ft. from E. Line

Ft. from W. Line

1931

Date _____

REPORT

6/10	Shov. oil 6'30"
6/17	5D for 5"
6/24	11/4
7/1	11/10
7/8	11/18
7/15	11/24
7/22	12/2
7/29	12/9
8/5	12/16
8/12	12/22
8/19	12/30
8/26	1932
9/2	176
9/9	11/3
9/16	11/9 TD 6'30"
9/23	Dry & Abandon
9/30	
10/7	
10/14	
10/21	
10/28	

Tha shall

KANSAS
Map No. 146 Sec. 13 Twp. 2 R. 6 E
Well No. 1 Kunkle

Blaser et al Company
Contractor

COMPLETED

SECTION PLAT

		0	

Ft. from N. Line
1070 Ft. from S. Line
750 Ft. from E. Line
Ft. from W. Line

ABANDONED

Location

RECORD

Cased in., ft.

Rig up

Sand

Drilling and Remarks:

Gas

Oil

Total Depth 630

PRODUCTION

1st 24 hrs. Nat.

1st 24 hrs. after shot

Gas Cu. Ft.

Dry Hole

Abandoned

Date

JAN 20 1932

192

CHAS. L. SHERWOOD

Scout

Marshall

KANSAS
Map No. 146 Sec. 13 Twp. 2 R. 6 E
Well No. 1 Kunkle

Blaser et al Company
Contractor

FIRST REPORTS

SECTION PLAT

		0	

Ft. from N. Line
1070 Ft. from S. Line
750 Ft. from E. Line
Ft. from W. Line

Location

RECORD

Cased in., ft.

Rig up

Sand

Drilling and Remarks:

Gas

Oil

Total Depth

Show oil 630
D/O for 5"

PRODUCTION

1st 24 hrs. Nat.

1st 24 hrs. after shot

Gas Cu. Ft.

Dry Hole

Abandoned

Date

JUN 10 1931

192

CHAS. L. SHERWOOD

Scout