

15117000180000
FORM 51 25M 8-50 WESTERN


Marshall **KANSAS**

Section 34 Township 2 Range 8E

Well No. #1 Suggett

Company Herbert Groge et al

NORTH

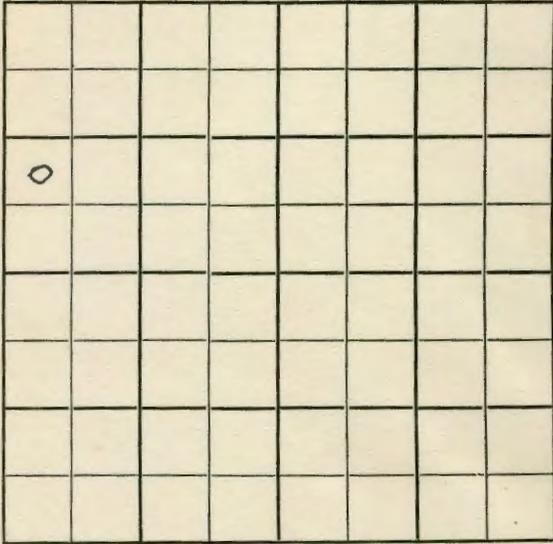

SOUTH

5

FORM 252-B
10M 11-50 PETROL

Marshall

KANSAS

Sec. 34 Twp. 2 R. 8E

Well No. #1 Suggett

Herbert Groge et al Company

H. J. Uhle Contracto

Wildcat

Ft. from N. Line


990 Ft. from S. Line

Ft. from E. Line

330 Ft. from W. Line

NW SW NW

NORTH

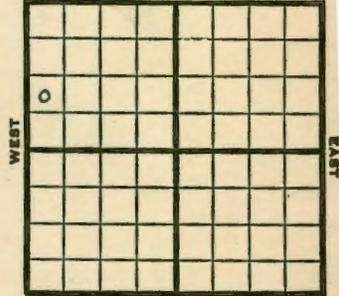

SOUTH

1951 **Elev. 1335'** REPORT

6/6 Spud 5-27-51
8-5/8" @ 105
Drlg. 1400'

6/20 Spud 5-27-51
D&A TD 2373
8-5/8" @ 105
TD 2373
D&A

ABANDONED

