



Section 11  
 Township 30 S  
 Range 4~~W~~

Cowley County  
Goslin Farm No. \_\_\_\_\_  
 \_\_\_\_\_ Company  
 Sec. \_\_\_\_\_ Twp. \_\_\_\_\_

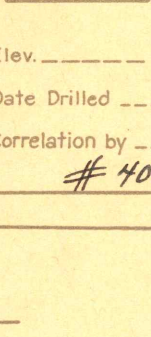

Twp.	
6	5
7	8
18	17
19	20
30	29
31	32
4	3
9	10
16	15
21	22
28	27
33	34
2	1
11	12
14	13
23	24
26	25
35	36

Elev. \_\_\_\_\_ T.D. \_\_\_\_\_  
 Date Drilled \_\_\_\_\_  
 Correlation by J.E.L.  
# 405

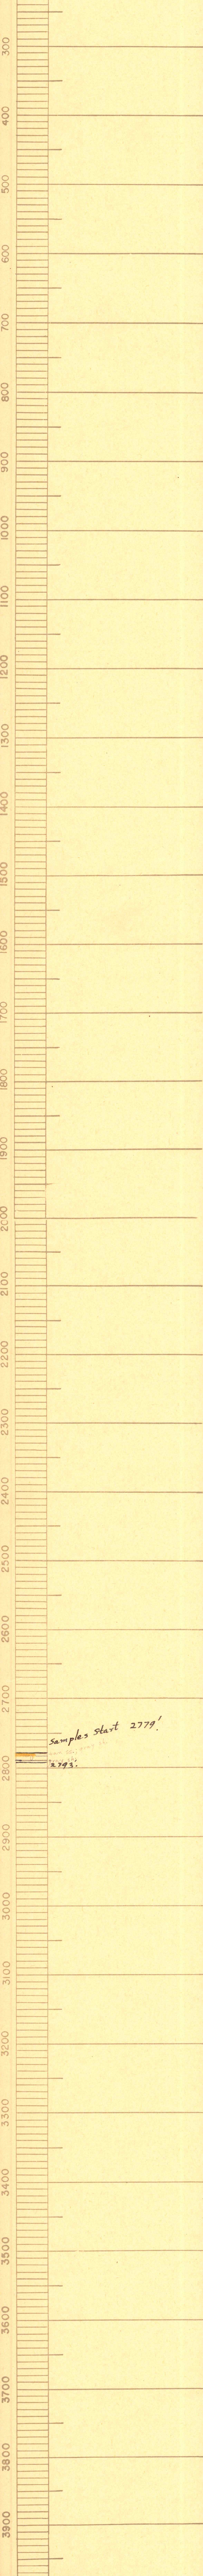

*samples start 2779'*  
 tan ss.; gray sh.  
 gray sh.  
 2793.

