


SEC. 16 TWP. 30S R. 14E

WELL NO. #1 Stryker FARM

COMPANY Aladdin Petroleum Corporation

CONTRACTOR Ray Burgin Well Service & Drlg. Co.

_____ Ft. from N. Line
 _____ Ft. from S. Line
 _____ Ft. from E. Line
 _____ Ft. from W. Line

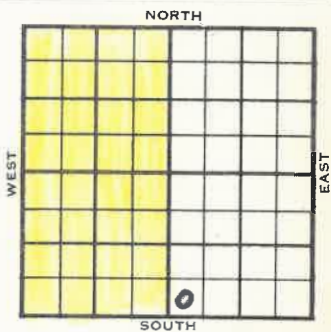

SW SW SE
 \$1250.00
 Dry hole Contribution

1956 ELEVATION 1026' GR 1030' REPORT (WH6-DC7)

- 7/6 To Start by August 1, 1956 *No FR*
 To Complete by September 1, 1956
 Arbuckle lime test Approx 2000'
 (See DHC Letter)
 Comm. 7-12-56
- 7/12 Set 41' of surface pipe w/10 sax. cmt.
 (Card-Aladdin Petr)
- 7/13 Drlg. 319' sandstone. "
- 7/14 Drlg. 590'
 Top of shallow gas sand @ 430'
 No shows. "
- 7/16 Drlg. 1060' lime.
 DST #1, 717-750', opened with weak
 blow, increased to good blow after
 40 mins. open 1 1/2 hrs, closed 15 mins.
 recovered 113' wtr.
 Top Big Lime 558', Top Squirrel sand
 664'. Show in lime below Squirrel
 Sand. (Card-Aladdin Petro.)
- 7/18 Drlg. 13' of Mississippi sand at 1411'
 good porosity, no odor & no stain.
 Drlg. ahead. (Card-Aladdin Petr)
- 7/19 Drlg. 1495' Miss. Lime. "
- 7/20 Drlg. 1540' in Miss. Lime. "

OVER

1956
7/27

Received copy of Geological Report.
Given to S.A. Shannon, Wichita District
Division Geologist.

Geological Report: X

Formation descriptions: T Layton Sand
445' (+585) T. KC 545' (+485)

T. Cleve Sd 669 (+361), T.Marmaton
Lime 698 (+332), Zone of porosity
728-35'

DST #1, 717-54, open w/weak blow,
increased to good blow 40 mins, open
1½ hrs, rec 113' wtr. IFP 20#.FFP 65#
BHP 165#. HH 345#.

T. Weiser Sd 916 (+114), T. Pawnee
Lime 976 (+54) T. Ft. Scott 1052 (-22)

Cherokee Section 1097' (-67)

T. Skimmer (?) Squirrel(?) 1215'(-185)

Core #1, 1237-56'

Sand 1258' (-228)

Core #2, 1300-1313'

T. Bartlesville 1309' (-279)

T. Mississippi 1398 (-368)

T. Kinderhook shale 1653' (-623)

T. Arbuckle 1664 (-634)

TD 1695' P & A

(According to information available
the well appeared 100' lower on top
of the Miss. than an old well 1/2 mile
West in the NENE of sec. 20-30S-14#.
After careful analysis of samples and
electric log, along w/1 negative DST,
it was recommended this be plugged &
abandoned.) (See Geological report)

ABANDONED

7/27

Advised Contract Section - D & A

7/30

Received copy of Electric Log and
copy of MicroLog. Given to S. A.
Shannon, Div. Geolog, Wichita District