

KANSAS DRILLERS LOG

S. 12 T. 30 R. 20 E W

API No. 15 — 133 — 20,483  
County Number

Loc. 330 NSL 330 WEL SE

County Neosho

Operator  
Ed Thiessen

Address  
R. R. #1 Parsons, Kansas

Well No. #2 Lease Name Thiessen


Footage Location  
330 feet from (N) (S) line 330 feet from (E) (W) line

Principal Contractor Self Geologist

Spud Date Oct 25 - 74 Total Depth 163 P.B.T.D.

Date Completed Dec 14 - 74 Oil Purchaser own use

640 Acres  
N

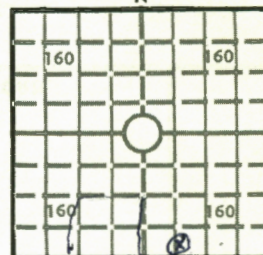

Locate well correctly

Elev.: Gr. \_\_\_\_\_

DF \_\_\_\_\_ KB \_\_\_\_\_

CASING RECORD

Report of all strings set — surface, intermediate, production, etc.

Purpose of string	Size hole drilled	Size casing set (in O.D.)	Weight lbs/ft.	Setting depth	Type cement	Sacks	Type and percent additives
Surface pipe to protect fresh water	10"	8 3/4"		40ft	portland	3	✓

LINER RECORD

PERFORATION RECORD

Top, ft.	Bottom, ft.	Sacks cement	Shots per ft.	Size & type	Depth interval

Size	Setting depth	Packer set at
2"	142"	139

ACID, FRACTURE, SHOT, CEMENT SQUEEZE RECORD

Amount and kind of material used	Depth interval treated

INITIAL PRODUCTION

Date of first production	Producing method (flowing, pumping, gas lift, etc.)
RATE OF PRODUCTION PER 24 HOURS	Oil bbls. Gas MCF Water bbls. Gas-oil ratio CFPB
Disposition of gas (vented, used on lease or sold)	Producing interval (s)
Used on lease	

INSTRUCTIONS: As provided in KCC Rule 82-2-125, within 90 days after completion of a well, one completed copy of this Drillers Log shall be transmitted to the State Geological Survey of Kansas, 4150 Monroe Street, Wichita, Kansas 67209. Copies of this form are available from the Conservation Division, State Corporation Commission, 3830 So. Meridian (P.O. Box 17027), Wichita, Kansas 66217. Phone AC 316-522-2206. If confidential custody is desired, please note Rule 82-2-125. Drillers Logs will be on open file in the Oil and Gas Division, State Geological Survey of Kansas, Lawrence, Kansas 66044.

Operator

Ed THIESSEN

DESIGNATE TYPE OF COMP.: OIL, GAS, DRY HOLE, SWDW, ETC.:

Gas

Well No.

THIESSEN #2

Lease Name

Same

S 12 T 30 R 20 E W

WELL LOG


Show all important zones of porosity and contents thereof; cored intervals, and all drill-stem tests, including depth interval tested, cushion used, time tool open, flowing and shut-in pressures, and recoveries.

SHOW GEOLOGICAL MARKERS, LOGS RUN, OR OTHER DESCRIPTIVE INFORMATION.

FORMATION DESCRIPTION, CONTENTS, ETC.	TOP	BOTTOM	NAME	DEPTH
Sandy Loam	0	5		
Clay	5	20		
Sand	20	33		
Limestone	33	63		
Black Slate	63	66		
Gray shale	66	<del>123</del>		
Black sandy shale		114		
	114	123		
Lime Stone	123	145		
Black sandy shale (Gas)	145	151		
Lime Stone	151	157		
Black sandy shale Gas	157	161		
Gray sandy shale	161	164		

USE ADDITIONAL SHEETS, IF NECESSARY, TO COMPLETE WELL RECORD.

Date Received

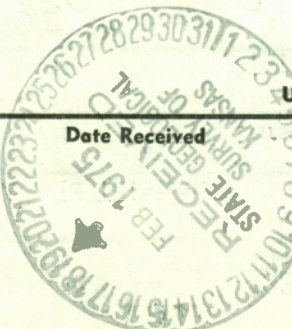

Ed Thiesen

Signature

owner

Title

1-3-75

Date

h89LHS

19-30-906