

State Geological Survey
WICHITA, BRANCH

31-30-22E ✓

KANSAS DRILLERS LOG

S. 31 T. 30 R. 22 ^E/_W

API No. 15 — 037 — 20,160
County Number

Loc. 630' S & 1500' W of NEc

County Crawford ^{41693 FSL & 1500 F6}
NE NW NE

Operator

Cities Service Oil Co.

Address

700 Sutton Place Bldg., Wichita, Kansas 67202

Well No.

#1

Lease Name

McGown "A"

NE NW NE - NAD83

Footage Location

630' S. + 1500' W. of NE/e
feet from (N) (S) line

41693 FSL & 1500 FEL
feet from (E) (W) line

Principal Contractor

Exploration, Inc.

Geologist

Bill Almon

Spud Date

11/26/74

Total Depth


130

P.B.T.D.

Date Completed

11/26/74

Oil Purchaser

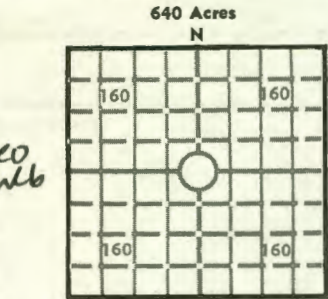

Locate well correctly
Elev.: Gr. 894

DF _____ KB _____

CASING RECORD

Report of all strings set— surface, intermediate, production, etc.

| Purpose of string | Size hole drilled | Size casing set (in O.D.) | Weight lbs/ft. | Setting depth | Type cement | Sacks | Type and percent additives |
|-------------------|-------------------|---------------------------|----------------|---------------|----------------|-------|----------------------------|
| Surface | 8 5/8" | 7" | | 20' | Did not cement | | |
| | | | | | | | |
| | | | | | | | |
| | | | | | | | |

LINER RECORD

PERFORATION RECORD

| Top, ft. | Bottom, ft. | Sacks cement | Shots per ft. | Size & type | Depth interval |
|----------|-------------|--------------|---------------|-------------|----------------|
| | | | | | |
| | | | | | |
| | | | | | |

TUBING RECORD

| Size | Setting depth | Packer set at |
|------|---------------|---------------|
| | | |
| | | |
| | | |

ACID, FRACTURE, SHOT, CEMENT SQUEEZE RECORD

| Amount and kind of material used | Depth interval treated |
|----------------------------------|------------------------|
| | |
| | |
| | |
| | |

INITIAL PRODUCTION

| | | | | | |
|--|-------|---|------------------------|---------------|--|
| Date of first production | | Producing method (flowing, pumping, gas lift, etc.) | | | |
| RATE OF PRODUCTION PER 24 HOURS | Oil | Gas | Water | Gas-oil ratio | |
| | bbls. | MCF | bbls. | CFPB | |
| Disposition of gas (vented, used on lease or sold) | | | Producing interval (s) | | |

INSTRUCTIONS: As provided in KCC Rule 82-2-125, within 90 days after completion of a well, one completed copy of this Drillers Log shall be transmitted to the State Geological Survey of Kansas, 4150 Monroe Street, Wichita, Kansas 67209. Copies of this form are available from the Conservation Division, State Corporation Commission, 3830 So. Meridian (P.O. Box 17027), Wichita, Kansas 66217. Phone AC 316-522-2206. If confidential custody is desired, please note Rule 82-2-125. Drillers Logs will be on open file in the Oil and Gas Division, State Geological Survey of Kansas, Lawrence, Kansas 66044.

Operator

Cities Service Oil Company

DESIGNATE TYPE OF COMP.: OIL, GAS, DRY HOLE, SWDW, ETC.:

Well No.

#1

Lease Name

McGown "A"

Strat - Test

S 31 T 30 R 22 E

WELL LOG

Show all important zones of porosity and contents thereof; cored intervals, and all drill-stem tests, including depth interval tested, cushion used, time tool open, flowing and shut-in pressures, and recoveries.

SHOW GEOLOGICAL MARKERS, LOGS RUN, OR OTHER DESCRIPTIVE INFORMATION.

FORMATION DESCRIPTION, CONTENTS, ETC.

TOP

BOTTOM

NAME

DEPTH

Log Attached

USE ADDITIONAL SHEETS, IF NECESSARY, TO COMPLETE WELL RECORD.



Glenn E. Meier
Glenn E. Meier Signature

Oil & Gas Systems Supervisor

1-10-75

Date

50484