

STATE CORPORATION COMMISSION OF KANSAS
OIL & GAS CONSERVATION DIVISION
WELL COMPLETION OR RECOMPLETION FORM
ACO-1 WELL HISTORY
DESCRIPTION OF WELL AND LEASE

Operator: License # 8462
Name LOREN SMITH
Address 0 SW 90 KANSAS
R-R-1
City/State/Zip 67356

Purchaser SATARA OIL CO.
INDEPENDENCE KANSAS

Operator Contact Person MELBA CLAWSON
Phone 316-632-4904

Contractor: License # 07897
Name MELBA CLAWSON

Wellsite Geologist LOREN SMITH
Phone 316-827-6264

Designate Type of Completion

☒ New Well ☐ Re-Entry ☐ Workover
☒ Oil ☐ SWD ☐ Temp Abd
☐ Gas ☐ Inj ☐ Delayed Comp.
☐ Dry ☐ Other (Core, Water Supply etc.)

If ONNO: old well info as follows:

Operator MELBA CLAWSON
Well Name CLAWSON #4
Comp. Date 9-4-86 Old Total Depth 216

WELL HISTORY

Drilling Method:

☐ Mud Rotary ☐ Air Rotary ☒ Cable

8/18/86 9/2/86 9/4/86
Spud Date Date Reached TD Completion Date

216 216
Total Depth PBTD

Amount of Surface Pipe Set and Cemented at 20 feet
Multiple Stage Cementing Collar Used? ☐ Yes ☒ No

If yes, show depth set.....feet

If alternate 2 completion, cement circulated
from 30 feet depth to 30 w/ 4 SX cmt
Cement Company Name SOUTHERLAND
Invoice # 50456

API NO. 15- 037-21, 382

County Crawford
SW SW SW
NE SW NW Sec. 34 Twp. 30 Rge. 22 East West
3840 165FSL 4690FEL - KU record
4140 Ft North from Southeast Corner of Section
Ft West from Southeast Corner of Section

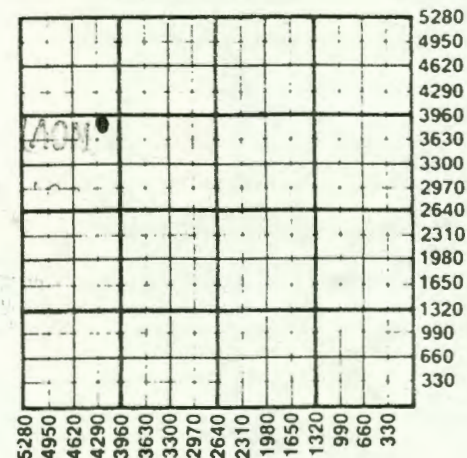
(Note: Locate well in section plat below)

Lease Name M. CLAWSON Well # 4

Field Name CLAWSONProducing Formation BARTLESVILLE

Elevation: Ground 535 KB 190

Section Plat

☒ WATER SUPPLY INFORMATION

Disposition of Produced Water: ☐ Disposal
Docket # ☐ Repressuring

Questions on this portion of the ACO-1 call:

Water Resources Board (913) 296-3717

Source of Water:

Division of Water Resources Permit #.....

Groundwater.....Ft North from Southeast Corner
(Well) Ft West from Southeast Corner of
Sec Twp Rge East West

Surface Water.....Ft North from Southeast Corner
(Stream, pond etc).....Ft West from Southeast Corner
Sec Twp Rge East West

Other (explain).....
(purchased from city, R.W.D. #)

INSTRUCTIONS: This form shall be completed in triplicate and filed with the Kansas Corporation Commission, 200 Colorado Derby Building, Wichita, Kansas 67202, within 120 days of the spud date of any well. Rule 82-3-130, 82-3-107 and 82-3-106 apply.
Information on side two of this form will be held confidential for a period of 12 months if requested in writing and submitted with the form. See rule 82-3-107 for confidentiality in excess of 12 months.
One copy of all wireline logs and drillers time log shall be attached with this form. Submit CP-4 form with all plugged wells. Submit CP-111 form with all temporarily abandoned wells.