

Geological Survey
WICHITA BRANCH
WELL COMPLETION REPORT AND
DRILLER'S LOG

KANSAS

API No. 15 — 037 — 20,392
County Number

Operator

Doyle Largent

Address 1309 South Elm Pittsburg, Kansas 66762

Well No. Lease Name

#2 Allen Bennett

Footage Location 1047' KCC Record 1323 FEL 1320'
feet from (E) (S) line feet from (E) (W) line

Principal Contractor Geologist

Doyle Largent

Spud Date Date Completed Total Depth P.B.T.D.

7-23-79 8-18-79 253'

Directional Deviation None Oil and/or Gas Purchaser None

15-037-20392
33-30-226

S. 33 T. 30 R. 22 E


1323 FEL

Loc. 1320' FWL & 1047' FSL

County Crawford

640 Acres

N

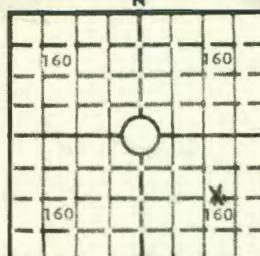

Locate well correctly

Elev.: Gr. 912'

DF KB

CASING RECORD

Report of all strings set—surface, intermediate, production, etc.

Purpose of string	Size hole drilled	Size casing set (in O.D.)	Weight lbs/ft.	Setting depth	Type cement	Sacks	Type and percent additives
To protect fresh water	6 1/8"	5 1/2"		100'	Portland	6	30% lime
Casing	6 1/8"	2"		226'	Portland	13	30% lime

LINER RECORD

PERFORATION RECORD

Top, ft.	Bottom, ft.	Sacks cement	Shots per ft.	Size & type	Depth interval

TUBING RECORD

Size	Setting depth	Packer set at

ACID, FRACTURE, SHOT, CEMENT SQUEEZE RECORD

Amount and kind of material used	Depth interval treated
Shot with 56 containers of Kinepak (2x8 cannisters)	

INITIAL PRODUCTION


Date of first production	Producing method (flowing, pumping, gas lift, etc.)			
RATE OF PRODUCTION PER 24 HOURS	Oil bbls.	Gas MCF	Water bbls.	Gas-oil ratio CFPB

Disposition of gas (vented, used on lease or sold)	Producing interval(s)

INSTRUCTIONS: As provided in KCC Rule 82-2-125, within 90 days after completion of a well, one completed copy of this Drillers Log shall be transmitted to the State Geological Survey of Kansas, 4150 Monroe Street, Wichita, Kansas 67209. Copies of this form are available from the Conservation Division, State Corporation Commission, 245 No. Water, Wichita, Kansas 67202. Phone AC 316-522-2206. If confidential custody is desired, please note Rule 82-2-125. Drillers Logs will be on open file in the Oil and Gas Division, State Geological Survey of Kansas, Lawrence, Kansas 66044.

Operator

DESIGNATE TYPE OF COMP.: OIL, GAS,
DRY HOLE, SWDW, ETC.:

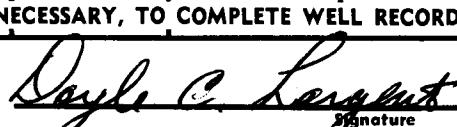Well No.	Lease Name			
2	Allen Bennett			
S 33 T 30 R 22 E XX				
WELL LOG				
Show all important zones of porosity and contents thereof; cored intervals, and all drill-stem tests, including depth interval tested, cushion used, time tool open, flowing and shut-in pressures, and recoveries.				
FORMATION DESCRIPTION, CONTENTS, ETC.	TOP	BOTTOM	NAME	DEPTH
Soil & Clay	0	10'		
Lime	10	25		
Shale Dark	25	30		
Lime	30	32		
Shale light	32	128		
Shale Dark	128	133		
Shale light	133	138		
Shale Dark	138	143		
Lime	143	146		
Shale Dark	146	148		
Shale light	148	158		
Shale dark	158	168		
Shale light	168	188		
Shale Sandy	188	228		
Oil Sand	228	241		
USE ADDITIONAL SHEETS, IF NECESSARY, TO COMPLETE WELL RECORD.				
Date Received	 <small>Signature</small> <u>Doyle C. Largent</u> <u>Owner</u> <small>Title</small> <u>9-24-79</u> <small>Date</small>			

19LHES