

API NO. 15-037-21,400

County Crawford
 SE SW
 NE SW NW Sec. 34 Twp. 30 Rge. 22 East
 West

(Note: Locate well in section plat below)

Field Name.....CLAWSON.....

Producing Formation.. Bartlesville.....

Elevation: Ground.....481.....KB.....

Operator Contact Person Larson S. Smith
Phone 827-6264

Contractor: License # 8462
Name Loren Smith

Wellsite Geologist. Loren Smith
Phone. 827 6264

Designate Type of Completion

☒ New Well ☐ Re-Entry ☐ Workover

☒ Oil ☐ SWD ☐ Temp Abd **KAN**

☐ Gas ☐ Inj ☐ Delayed Comp.

☐ Dry ☐ Other (Core, Water Supply etc.)

If ONWG: old well Info as follows:

Operator
Well Name
Comp. DateOld Total Depth.....

AUG 04 1987

Drilling Method: Mud Rotary Air Rotary ☒ Cable

5-1-87 6-1-87 7-9-87

Soud Date	Date Reached TD	Completion Date
-----------	-----------------	-----------------

223 none

Total Depth	PBTD
-------------	------

Amount of Surface Pipe Set and Cemented at 20 feet

Multiple Stage Cementing Collar Used? Yes ☒ No ☐

If yes, show depth set.....feet

If alternate 2 completion, cement circulated
from 201 feet depth to 0 w/ 28 SX cm

Cement Company Name CASEY BROS.

Invoice # 6704


METHOD OF COMPLETION

Disposition of gas: ☐ Vented
☐ Sold
☐ Used on Lease

☒ Open Hole ☐ Perforation
☐ Other (Specify)

☐ Dually Completed

One copy of all wireline logs and drillers time log shall be attached with this form. Submit CP-4 form with all plugged wells. Submit CP-111 form with all temporarily abandoned wells.

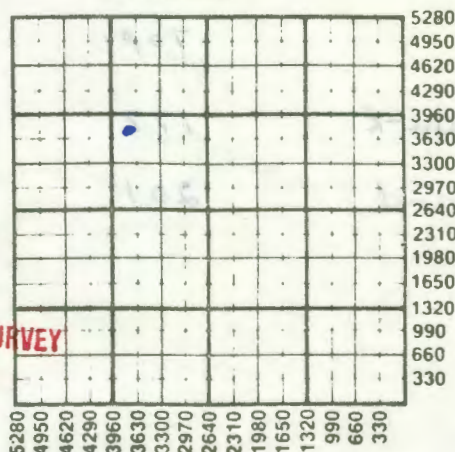

WATER SUPPLY INFORMATION

Disposition of Produced Water: _____ Disposal
Docket # N.A. Repressuring

Questions on this portion of the ACO-1 call:

Water Resources Board (913) 296-3717

Source of Water:

Division of Water Resources Permit #.....*NA*.....

Groundwater.....Ft North from Southeast Corner
(Well)Ft West from Southeast Corner of

Sec	Twp	Rge	East	West
-----	-----	-----	------	------

Surface Water.....Ft North from Southeast Corner
(Stream, pond etc).....Ft West from Southeast Corner

Sec	Twp	Rge	East	West
-----	-----	-----	------	------

✓ Other (explain) farm Pond

(purchased from city, R.W.D. #)

Production Interval

201

223

SIDE TWO

Operator Name Lorcu Smith Lease Name Clawson Well # 8Sec. 34 Twp. 30 Rge. 22 ☒ East ☐ West County Crawford

Estimated Production Per 24 Hours	Oil	Gas	Water	Gas-Oil Ratio	Gravity
		Bbls	MCF	Bbls	CFPB

1 -2 1/4

Drill Stem Tests Taken ☐ Yes ☒ No
 Samples Sent to Geological Survey ☐ Yes ☒ No
 Cores Taken ☐ Yes ☒ No

Formation Description
☐ Log ☐ Sample

Name	Top	Bottom
Sandy dark	177	201
OIL Sand	201	223
		TD

Name	Top	Bottom
Casing	0	21
Light Gray Shale	60	81
Dark Gray Shale	81	111
Black shale	111	114
Light Gray Shale	114	119
Lime Rock	119	123
Gray Shale	123	125
Black Shale	125	127
Lime Rock	127	129
Black Shale	129	134
Gray Shale	134	139
Sandy Gray Shale	139	147
Gray Shale	147	154
Lime Rock	154	157
Light Gray	157	165
Lime Rock	165	167
Dark Shale	167	17

CASING RECORD ☒ New ☐ Used							
Report all strings set-conductor, surface, intermediate, production, etc.							
Purpose of String	Size Hole Drilled	Size Casing Set (In O.D.)	Weight Lbs/Ft.	Setting Depth	Type of Cement	#Sacks Used	Type and Percent Additives
surface	7 inch	6 5/8	7	20	Monarch	4	NONE
production	7 inch	2 7/8	14	201	Monarch	24	NONE

PERFORATION RECORD		Acid, Fracture, Shot, Cement Squeeze Record (Amount and Kind of Material Used)	
Shots Per Foot	Specify Footage of Each Interval Perforated		Depth
	OPEN HOLE	60 Sacks of Sand	201-221
		100 Gals water (salt)	
		250 Gals	

TUBING RECORD		Liner Run ☐ Yes ☒ No	
Size	Set At	Packer at	
2 3/8	201	201	

Date of First Production	Producing Method
7-10-87	☐ Flowing ☒ Pumping ☐ Gas Lift ☐ Other (explain).....