


Exelby

Company *Kleinschmidt*  
 Farm No. *1*  
 Total Depth  
 Comm.  
 Shot or Treated  
 Contractor  
 Issued

19-30-22E  
 Sec. *19* T. *30* R. *22* E  
 Loc. *NE - NE-NW*  
*450' N line*  
*100' E line*

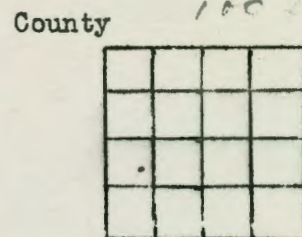

Casing  
 20 in.  
 15 1/2  
 12 1/2  
 13 3/8  
 10 in.  
 8 1/4  
 6 5/8 *270 ft*  
 5 3/16

Elevation  
 Production

Figures Indicate Bottom of Formation

*4 soil 4*  
*1 — 5*  
*4 gray 19*  
*1 — 10*  
*5 gray 115*  
*16 dl 31*  
*3 — 34*  
*5 dl 39*  
*16 dl 55*  
*5 — 60*  
*6 dl 66*  
*13 g 1 79*  
*17 1/2 — 96 1/2*  
*5 dl 79*  
~~*17 1/2 — 96 1/2*~~  
*5 dl 121*  
*11 dl 132*

*70 dl 202*  
*4 Brkn — 206*  
*3 dl 209*  
*9 gray 1 218*  
*3 — 221*  
*4 dl 225*  
*2 — 227*  
*4 dl 231*  
*11 g 1 242*  
*10 dl 252*  
*18 g 1 270*  
*15 — 1 285*  
*17 good — 302*  
*2 Brkn — 304*  
*14 good — 318*  
*with oil*

*Heavy flow wtr.*

*TD*