

Bk 3400

Sec 24-30-24

THE HULL & DILLON PACKING COMPANY

ESTABLISHED 1885

PORK AND BEEF PACKERS

PITTSBURG, KANSAS

COMPLETE LOG OF WELL NUMBER THREE

HULL & DILLON PACKING COMPANY

11/29-84

Stake line of 11/26/84

194.7

Yellow Dirt	18'-0"
Blue Shale	35'-0"
Showing of Coal	36'-0"
Dark Shale	51'-0"
White Sandy Shale	58'-0"
Black Shale	81'-0"
Hard Sand Rock	89'-0"
Dark Shale	112'-0"
Hard Sand Rock	116'-0"
Black Shale	133'-0"
Soft Rock & Shale	136'-0"
Black & Blue Shale	224'-0"
Rock & Blue Shale	233'-0"
Black Shale	239'-0"
Hard Rock Clevis Water	321'-0"
Lime & Flint	361'-0"
Water Flint	376'-0"
Lime & Flint	549'-0"
Blue Shale	573'-0"
Gray Lime	577'-0"
Blue Shale	583'-0"
Lime	625'-0"
Water Sand & Water Flint	633'-0"
Lime & Water Flint	711'-0"
Lime & Flint & Some Water	736'-0"
Lime & Flint - Big Crevice Water	811'-0"
Gray Lime & Flint	901'-0"
Hard Water Sand	921'-0"
Gray Lime	931'-0"
Hard Water Sand & White Lime	951'-0"
White Lime	964'-0"
Hard White Water Sand & W. Lime	968'-0"
Hard Cap Rock	970'-0"
Hard White Water Sand	981'-0"
Gray Lime	1,001'-0"
Gray Lime	1,023'-0"
White Lime & Sand	1,038'-0"
Big Crevis Water --	
Black Sulpher Water	1,039'-0"
Gray Lime & Flint	1,091'-0"

1926

162.0

1940

185.

1942

178.25

1954


194.7 11-26

Apr 5-55-

Well gone, air.

330' column, bawl +
12' suction pipe.

HOLE ABSOLUTELY STRAIGHT AND FULL 6 5/8" CLEAR TO THE BOTTOM OF WELL.

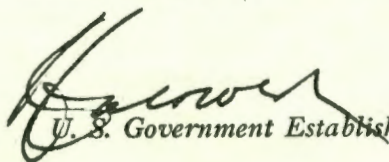

U. S. Government Establishment No. 510