

~~CONFIDENTIAL~~

KANSAS

**WELL COMPLETION REPORT AND
DRILLER'S LOG**

State Geological Survey
WICHITA BRANCH

S. 19 T. 31 R. 1 ^E
~~XXX~~
Loc. NW SE SE
County Sumner

API No. 15 — 191 — 21,335
County Number

Operator
George R. Jones

Address
125 N. Market, Suite 1310, Wichita, KS 67202


Well No. 1 Lease Name Maxwell

Footage Location
330 feet from (N) ~~XX~~ line 330 feet from ~~XX~~ (W) line

Principal Contractor R.R.A., Inc. Geologist Robert W. Hammond

Spud Date Oct. 13, 1981 Date Completed Oct. 22, 1981 Total Depth 3735' P.B.T.D.

Directional Deviation Oil and/or Gas Purchaser
Dry Hole

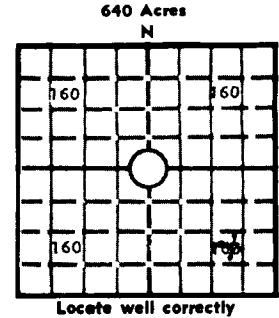

Elev.: Gr. 1324'
DF KB 1331'

CASING RECORD

Report of all strings set — surface, intermediate, production, etc.

Purpose of string	Size hole drilled	Size casing set (in O.D.)	Weight lbs/ft.	Setting depth	Type cement	Sacks	Type and percent additives
surface	12-1/4"	8-5/8"	20#	295	Common	180	2% gel 3% c.c.

LINER RECORD

PERFORATION RECORD

Top, ft.	Bottom, ft.	Sacks cement	Shots per ft.	Size & type	Depth interval

TUBING RECORD

Size	Setting depth	Packer set at

ACID, FRACTURE, SHOT, CEMENT SQUEEZE RECORD

Amount and kind of material used	Depth interval treated

RELEASED
Date: 1 OCT 1982
FROM CONFIDENTIAL

INITIAL PRODUCTION

Date of first production		Producing method (flowing, pumping, gas lift, etc.)			
RATE OF PRODUCTION PER 24 HOURS	Oil	Gas	Water	Gas-oil ratio	
	bbis.	MCF	bbis.	CFPB	
Disposition of gas (vented, used on lease or sold)			Producing interval(s)		

INSTRUCTIONS: As provided in KCC Rule 82-2-125, within 90 days after completion of a well, one completed copy of this Drillers Log shall be transmitted to the State Geological Survey of Kansas, 4150 Monroe Street, Wichita, Kansas 67209. Copies of this form are available from the Conservation Division, State Corporation Commission, 245 No. Water, Wichita, Kansas 67202. Phone AC 316-522-2206. If confidential custody is desired, please note Rule 82-2-125. Drillers Logs will be on open file in the Oil and Gas Division, State Geological Survey of Kansas, Lawrence, Kansas 66044.

Operator George R. Jones DESIGNATE TYPE OF COMP.: OIL, GAS, DRY HOLE, SWDW, ETC.: Dry Hole

Well No. 1 Lease Name Maxwell

S 19 T 31 S R 1 E WX


WELL LOG
 Show all important zones of porosity and contents thereof; cored intervals, and all drill-stem tests, including depth interval tested, cushion used, time tool open, flowing and shut-in pressures, and recoveries. SHOW GEOLOGICAL MARKERS, LOGS RUN, OR OTHER DESCRIPTIVE INFORMATION.

FORMATION DESCRIPTION, CONTENTS, ETC.	TOP	BOTTOM	NAME	DEPTH
---------------------------------------	-----	--------	------	-------

DST #1: 3632 - 3660 30" 45" 60" 60" weak blow throughout; rec. 15' OCM; 120' muddy water chlorides 32,000 ifp 30 - 50 ffp 60 - 110 isip 1445 fsip 1395 hyd. 1735 - 1715 temp. 113°			LOG TOPS: Lansing-KC B/KC Miss. Chert Dolomite LTD	2977 (-1646) 3223 (-1892) 3629 (-2998) 3633 (-3002) 3736 (-2405)
--	--	--	---	--

Fill hole with drilling mud from 3735' T.D. to 315', add 1/2 sx hulls, set plug; add 32 sx cement, add mud to 40'; add 1/2 sx hulls, set plug; add 10 sx cement. 3 sx cement in rathole; 3 sx cement in mouse hole.
 State Agent: Carl Barnett

USE ADDITIONAL SHEETS, IF NECESSARY, TO COMPLETE WELL RECORD.

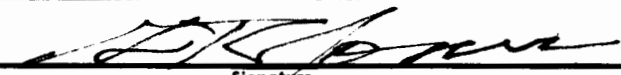Date Received	
	Signature
	Operator
	Title
	Oct. 23, 1981
	Date

10-31-1981