

33-31-1E  
P.I. Unit

SIDE ONE

STATE CORPORATION COMMISSION OF KANSAS  
OIL & GAS CONSERVATION DIVISION

WELL COMPLETION OR RECOMPLETION FORM  
ACO-1 WELL HISTORY

DESCRIPTION OF WELL AND LEASE

Operator: License # 5606  
Name R. J. Walker Oil Co., Inc.  
Address 3535 NW 58th Ste 1000  
Oklahoma City, Okla.  
City/State/Zip 73112

Purchaser None - Junked hole.

Operator Contact Person O. N. Goode  
Phone 405-949-2440

Contractor: License # 5133  
Name Kansas Drilling & Well Sery, Inc.

Wellsite Geologist  
Phone

Designate Type of Completion  
 New Well  Re-Entry  Workover

Oil  SWD  Temp Abd  
 Gas  Inj  Delayed Comp.  
 Dry - Junked  Other (Core, Water Supply etc)

If OWWO: old well info as follows:  
Operator  
Well Name  
Comp. Date Old Total Depth

WELL HISTORY

Drilling Method:  
 Mud Rotary  Air Rotary  Cable  
12-1-84 12-3-84 12-21-84  
Spud Date Date Reached TD Completion Date  
3515' 1634'  
Total Depth PBDT

Amount of Surface Pipe Set and Cemented at 288' feet  
Multiple Stage Cementing Collar Used?  Yes  No  
If yes, show depth set feet  
If alternate 2 completion, cement circulated from feet depth to w/SX cmt

API NO. 15-191-21-773  
County Summer

SW NW SW 33 31 Rge 1  East  West


1650 Ft North from Southeast Corner of Section  
4950 Ft West from Southeast Corner of Section  
(Note: Locate well in section plat below)

Lease Name R. Zimmerman Well # 1-33  
(R. Zimmerman #2-33 Replaces this well)  
Field Name Wildcat

Producing Formation Simpson Not Reached

Elevation: Ground 1297' KB 1305'

Section Plat

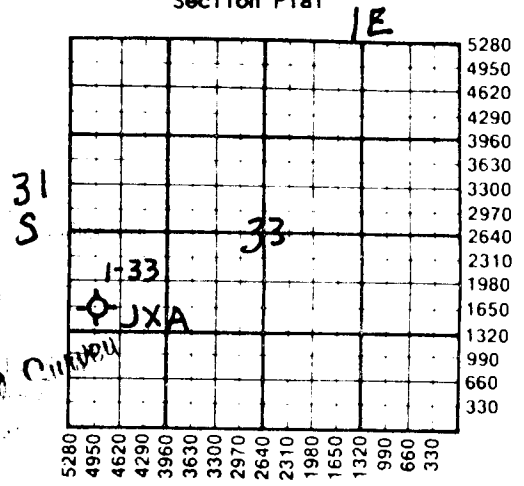

JUN 28 1985  
State Geologist  
WICHITA

WATER SUPPLY INFORMATION

Disposition of Produced Water:  Disposal  Repressuring  
Docket #

Questions on this portion of the ACO-1 call:

Water Resources Board (913) 296-3717  
Source of Water: City of Wellington  
Division of Water Resources Permit #

Groundwater Ft North from Southeast Corner (Well) Ft West from Southeast Corner of Sec Twp Rge  East  West

Surface Water Ft North from Southeast Corner (Stream, pond etc) Ft West from Southeast Corner Sec Twp Rge  East  West

Other (explain) Purchased from the city (purchased from city, R.W.D. #)

INSTRUCTIONS: This form shall be completed in duplicate and filed with the Kansas Corporation Commission, 200 Colorado Derby Building, Wichita, Kansas 67202, within 90 days after completion or recompletion of any well. Rule 82-3-130 and 82-3-107 apply.  
Information on side two of this form will be held confidential for a period of 12 months if requested in writing and submitted with the form. See rule 82-3-107 for confidentiality in excess of 12 months.  
One copy of all wireline logs and drillers time log shall be attached with this form. Submit CP-4 form with all plugged wells. Submit CP-111 form with all temporarily abandoned wells.

32-31-1E P1

SIDE TWO

Operator Name R. J. Walker Oil Co., Inc. Lease Name R. Zimmerman Well # 1-33

Sec. 33 Twp. 31 Rge. 1 East West County Sumner

WELL LOG

INSTRUCTIONS: Show important tops and base of formations penetrated. Detail all cores. Report all drill stem tests giving interval tested, time tool open and closed, flowing and shut-in pressures, whether shut-in pressure reached static level, hydrostatic pressures, bottom hole temperature, fluid recovery, and flow rates if gas to surface during test. Attach extra sheet if more space is needed. Attach copy of log.

Drill Stem Tests Taken [ ] Yes [ ] No
Samples Sent to Geological Survey [ ] Yes [ ] No
Cores Taken [ ] Yes [ ] No

No logs, Dst etc taken due to questionable nature of the high angles found in this crooked hole. Well junked and replaced by R. Zimmerman #2-33 Twin before reaching any of the prospective zones.

Formation Description

[ ] Log [ ] Sample

x Drillers Log x

Table with columns: Name, Top, Bottom. Rows: lime, shale (0-2983), Lans (2983-3110), Lans K.C. (3110-3300), K.C. (3300)

JUN 19 1935

State Geological Survey WICHITA BRANCH

CASING RECORD Form with fields for Purpose of String, Size Hole, Size Casing, Weight, Setting Depth, Type of Cement, #Sacks Used, Type and Percent Additives. Includes sections for PERFORATION RECORD and TUBING RECORD.