E

15 Range

S

31 Township

13 Section

Montgomery
County

Peters No. 1
Farm

Company

Sec.

Twp.

6	5	4	3	2	1
7	8	9	10	11	12
18	17	16	15	14	13
19	20	21	22	23	24
30	29	28	27	26	25
31	32	33	34	35	36

Elev. _____ T.D. 1447

Date Drilled _____

Correlation by _____
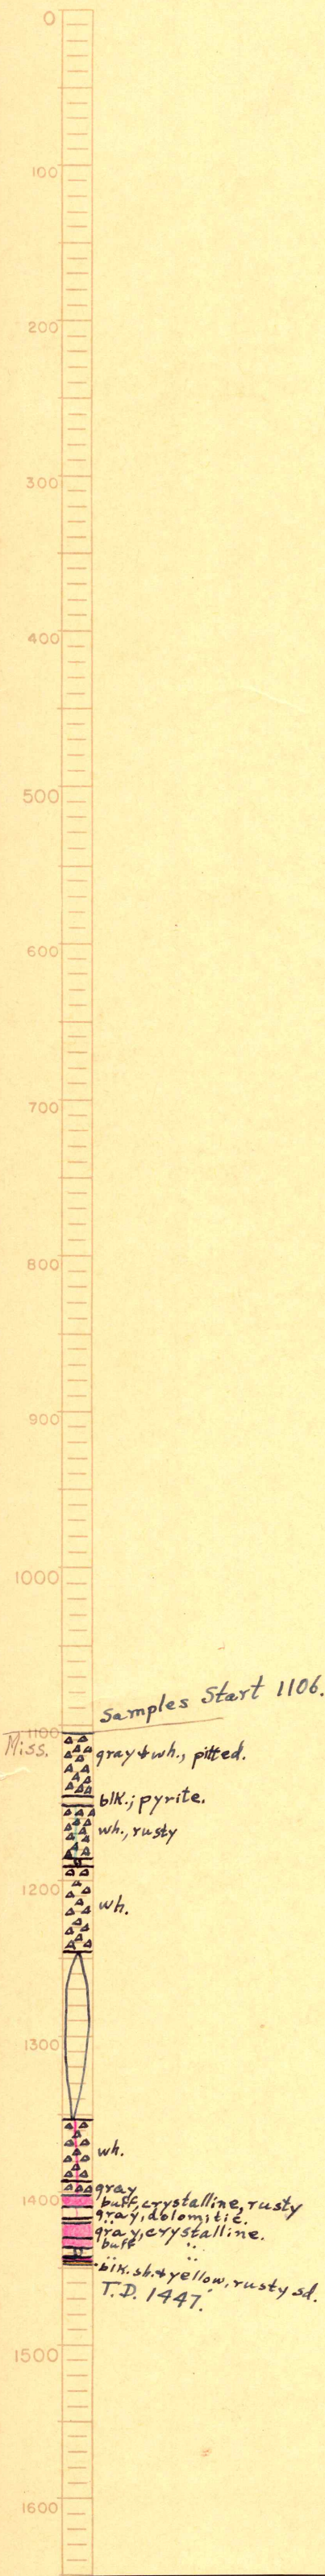
#188