

15-125-21544 S. 21 T. 34 S. R. 15 E W

State Geological Survey
WICHITA, BRANCH

DRILLERS LOG

API No. 15 - 125 - 21,544
County Number

Loc. 1155'FSL & 1155'FWL NW/4

County Montgomery

Operator
C.V. Robinson

Address
Route #1 Box 200B Independence, Kansas 67301


Well No. 101 Lease Name Robinson

Footage Location
1,155 feet from (N) (S) line 1,155 feet from (E) (W) line NW

Principal Contractor Dobbie Drilling Co. Geologist _____

Spud Date 10-21-77 Total Depth 1,200' P.B.T.D. _____

Date Completed 10-24-77 Oil Purchaser _____

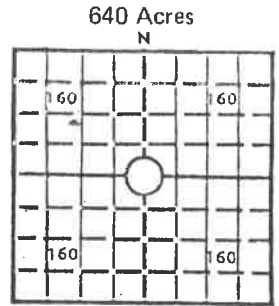

Locate well correctly

Elev.: Gr. _____

DF _____ KB _____

CASING RECORD

Report of all strings set—surface, intermediate, production, etc.

Purpose of string	Size hole drilled	Size casing set (in O.D.)	Weight lbs/ft.	Setting depth	Type cement	Sacks	Type and percent additives
SURFACE	9"	7"		50'	Portland	10	3% Cal.
PRODUCTION	6 1/2"	1 1/2"		1,198'			

WELL LOG

Show all important zones of porosity and contents thereof; cored intervals, and all drill-stem tests, including depth interval tested, cushion used, time tool open, flowing and shut-in pressures, and recoveries.

Formation	Top	Btm.	Formation	Top	Btm.	Formation	Top	Btm.
Soil	0	3	Lime	441	442	Lime	1113	1116
Clay	3	15	Shale	442	452	Shale	1116	1160
Shale	15	19	Lime	452	453	Oil Sand	1160	1184
Lime	19	20	Shale	453	471	Shale	1184	1191
Shale	20	30	Lime	471	472	Lime	1191	1200
Sand	30	40	Shale	472	474			
Shale	40	58	Lime	474	480			
Sand	58	80	Shale	480	546			
Shale	80	89	Lime	546	574			
Sand	89	109	Shale	574	706			
Shale	109	114	Lime	706	726			
Sand	114	132	Sandy Shale	726	827			
Shale	132	139	Lime	827	849			
Lime	139	141	Shale	849	860			
Shale	141	145	Lime	860	888			
Sand	145	218	Shale	888	892			
Lime	218	221	Lime	892	907			
Shale	221	222	Shale	907	916			
Lime	222	226	Sand	916	920			
Shale	226	302	Shale	920	938			
Lime	302	304	Lime	938	944			
Sandy Shale	304	310	Shale & Sand	944	955			
Lime	310	321	Lime	955	957			
Shale	321	441	Shale & Sand	957	1113			