


Cowley County
Hughes Farm No. 1

4
S
31
20
Range
Township
Section

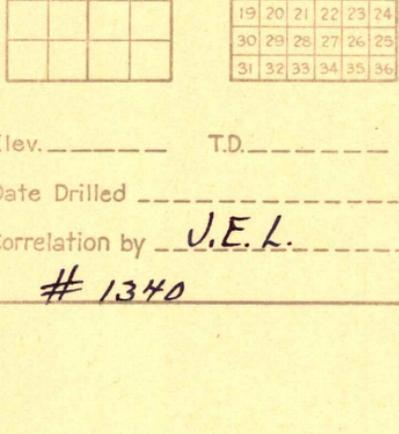

Elev. ----- T.D. -----
 Date Drilled -----
 Correlation by J.E.L.
 # 1340

