

STATE OF KANSAS
STATE CORPORATION COMMISSION


Give All Information Completely
Make Required Affidavit
Mail or Deliver Report to:
Conservation Division
State Corporation Commission
800 Bitting Building
Wichita, Kansas

WELL PLUGGING RECORD

Cowley

County. Sec. 21 Twp. 31S Rge. 4E (E) (W)

NORTH

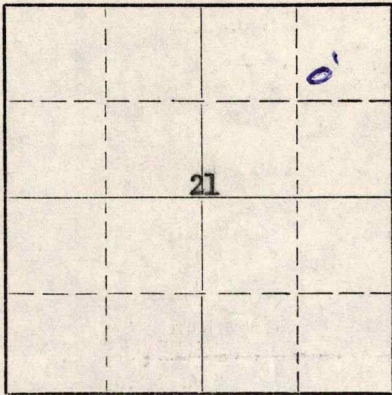

Locate well correctly on above
Section Plat

Location as "NE/CNW/SW" or footage from lines.

Lease Owner B.B. Blair

Lease Name Kerry Hittle Well No. 1

Office Address Tulsa, Okla.

Character of Well (completed as Oil, Gas or Dry Hole) Oil

Date well completed as an oil well 4-10-39 19

Application for plugging filed 19

Application for plugging approved 19

Plugging commenced May 21, 1953 19

Plugging completed May 27, 1953 19

Reason for abandonment of well or producing formation Would not produce in paying quantities

If a producing well is abandoned, date of last production 19

Was permission obtained from the Conservation Division or its agents before plugging was commenced? Yes

Name of Conservation Agent who supervised plugging of this well W.S. Lenaster

Producing formation Siliceous Lime Depth to top 3358 Bottom 3391 Total Depth of Well 3391 Feet

Show depth and thickness of all water, oil and gas formations.

OIL, GAS OR WATER RECORDS

CASING RECORD

FORMATION	CONTENT	FROM	TO	SIZE	PUT IN	PULLED OUT
<u>Siliceous Lime</u>	<u>Oil</u>	<u>3358</u>	<u>3391</u>	<u>7"OD</u>	<u>3358'</u>	<u>2326.25'</u>

Describe in detail the manner in which the well was plugged, indicating where the mud fluid was placed and the method or methods used in introducing it into the hole. If cement or other plugs were used, state the character of same and depth placed, from _____ feet to _____ feet for each plug set.

The above well was filled with cement from 3391' to 3341' then mud to 180' then rock to 170' then cement to 145' then mud to 18' then cement to 8' then mud to top of ground

Name of Plugging Contractor F.W. Kellum
Address 1218 Backney St. Winfield, Kansas

STATE OF Oklahoma, COUNTY OF Tulsa, ss.
Fred M. Warden (employee of owner) or (owner or operator) of the above-described well, being first duly sworn on oath, says: That I have knowledge of the facts, statements, and matters herein contained and the log of the above-described well as filed and that the same are true and correct. So help me God.

(Signature) [Signature]
(Address) _____

SUBSCRIBED AND SWORN TO before me this 8th day of June, 19 53

[Signature]
Notary Public.



24-2675-S 2-52-20M

COPY
Original Mailed To Cop Com - 6-8-53

OWLL