


E # _____
 Range _____
 Township _____
 Section _____
 County Cowley
 Farm Scott No. 1
 Company _____
 Sec. _____ Twp. _____
 Elev. _____ T.D. _____
 Date Drilled _____
 Correlation by J. E. L.
 # 1657

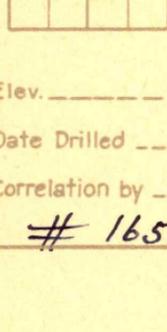

Twp.	
6	5
7	8
18	17
19	20
30	29
31	32

