

State Geological Survey
KANSAS DRILLERS LOG
WICHITA, BRANCH

IMPORTANT
Kans. Geo. Survey request
samples on this well.

API No. 15 — 021 — 20,094
County Number

Operator

Missouri Lead-Zinc Company

Address

1705 North Walnut Pittsburg, Kansas 66762

Well No.

#12-3-3

Lease Name

Larry Murray

Footage Location

1240 feet from (N) line 500 feet from (E) line

Principal Contractor

Nance Drilling

Geologist

Spud Date

10/7/75

Total Depth

425

P.B.T.D.


Date Completed

10/8/75

Oil Purchaser

29-34-250
S. 29 T. 31 R. 25 E
Loc. 500' W & 1400' N/SEc NE
County Cherokee

640 Acres
N

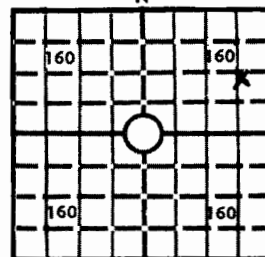

Locate well correctly

Elev.: Gr. 867

DF KB

CASING RECORD

Report of all strings set — surface, intermediate, production, etc.

Purpose of string	Size hole drilled	Size casing set (in O.D.)	Weight lbs/ft.	Setting depth	Type cement	Sacks	Type and percent additives
Surface	8"	6 5/8	7	20'			

LINER RECORD

PERFORATION RECORD

Top, ft.	Bottom, ft.	Sacks cement	Shots per ft.	Size & type	Depth interval

TUBING RECORD

Size	Setting depth	Packer set at

ACID, FRACTURE, SHOT, CEMENT SQUEEZE RECORD

Amount and kind of material used	Depth interval treated

INITIAL PRODUCTION

Date of first production		Producing method (flowing, pumping, gas lift, etc.)			
RATE OF PRODUCTION PER 24 HOURS	Oil	Gas	Water	Gas-oil ratio	
	bbls.	MCF	bbls.	CFPB	
Disposition of gas (vented, used on lease or sold)			Producing interval (s)		


INSTRUCTIONS: As provided in KCC Rule 82-2-125, within 90 days after completion of a well, one completed copy of this Drillers Log shall be transmitted to the State Geological Survey of Kansas, 4150 Monroe Street, Wichita, Kansas 67209. Copies of this form are available from the Conservation Division, State Corporation Commission, 3830 So. Meridian (P.O. Box 17027), Wichita, Kansas 66217. Phone AC 316-522-2206. If confidential custody is desired, please note Rule 82-2-125. Drillers Logs will be on open file in the Oil and Gas Division, State Geological Survey of Kansas, Lawrence, Kansas 66044.

Operator		DESIGNATE TYPE OF COMP.: OIL, GAS, DRY HOLE, SWDW, ETC.:
Well No. J2-3-3	Lease Name L. Murray	
S 29 T 31 R 25 E		

WELL LOG

Show all important zones of porosity and contents thereof; cored intervals, and all drill-stem tests, including depth interval tested, cushion used, time tool open, flowing and shut-in pressures, and recoveries.

FORMATION DESCRIPTION, CONTENTS, ETC.	TOP	BOTTOM	NAME	DEPTH
~~024~~ Overburden	0	14		
Shale	0	125		
Lime & chert	125	425		

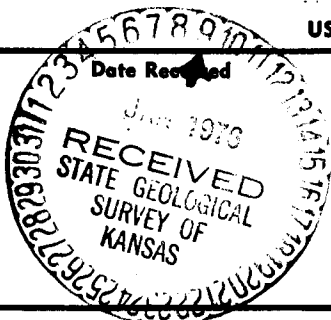**TIME**

Date _____

98-31-92C