


ELK

Map No. Kansas Sec. 29 Twp. 31 R. 10

Well No. 1 McCormick Farm
Neeley O. + G. Company

NORTH

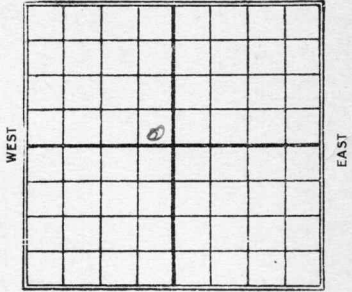

SOUTH

..... Ft. from N. Line

250 Ft. from S. Line

250 Ft. from E. Line

..... Ft. from W. Line

Date
1927

REPORT

1/8 S. + G. 2176

4 KANSAS ^{Edk} Sec. 29 Twp. 31 R. 10

Well No. 1 Mc Colmichy

Reeley Oil & Co Company

Contractor

FIRST REPORTS

SECTION PLAT

Ft. from N. Line

250 Ft. from S. Line

250 Ft. from E. Line

Ft. from W. Line

COMPLETED

		0	
ABANDONED			

Location

Rig up

Drilling and Remarks:

Oil
2176

RECORD

Cased _____ in., _____ ft.
 Sand _____
 Gas _____
 Oil _____
 Total Depth 2176

PRODUCTION

1st 24 hrs. Nat. _____
 1st 24 hrs. after shot _____
 Gas _____ Cu. Ft.
 Dry Hole
 Abandoned

Date JAN 8 1927

CHAS. L. SHERWOOD

192 Scout