9-54

STATE: Kansas	COMPANY: Saturn Drlg.
COUNTY: Cowley	FARM: Walker WELL NO.: 1
BLOCK	SURVEY
SEC.: 31	
T.: 31 R.: 8E	TOTAL DEPTH: 1950'
	N2-SE-SE
	COMMENCED
	COMPLETED
	REMARKS
ALTITUDE: 1331	
PRODUCTION: D&A	

CASING RECORD

SHOT	QUARTS	BETWEEN
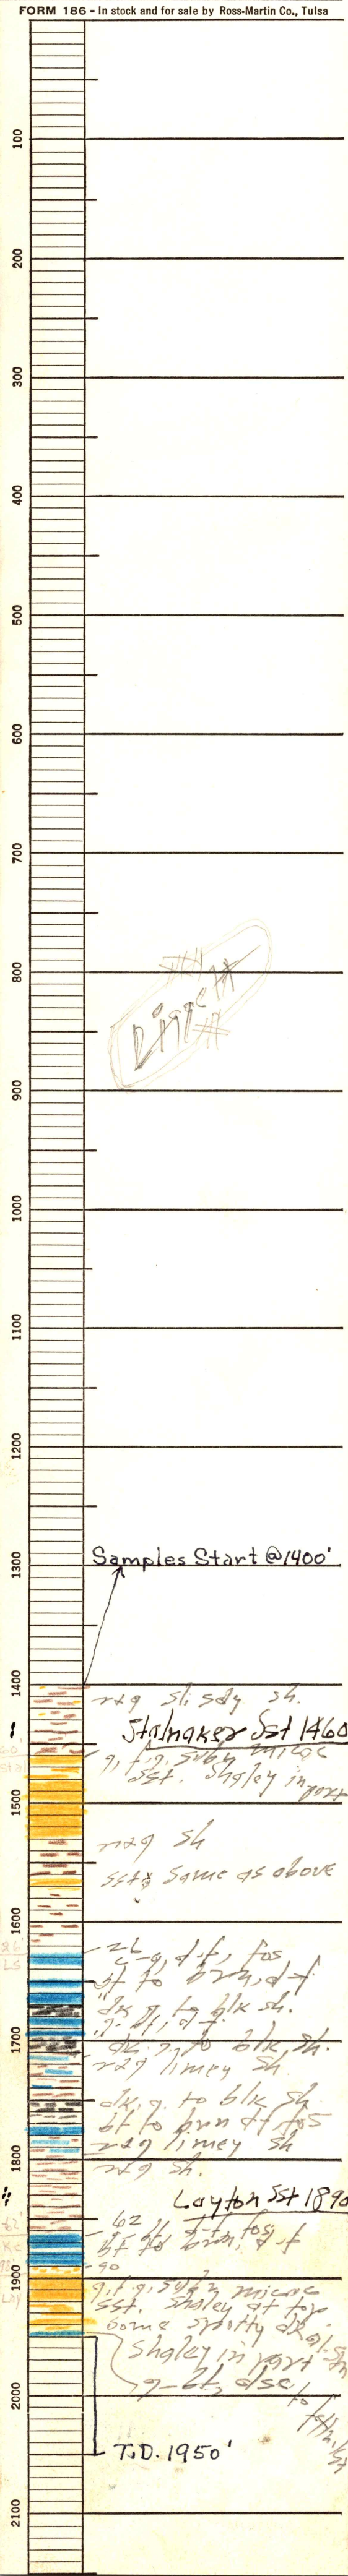
FORM 186 - In stock and for sale by Ross-Martin Co., Tulsa