


WELL LOG BUREAU—KANSAS GEOLOGICAL SOCIETY
 508 East Murdock, Wichita, Kansas

26-31-5E

Company- PURE OIL CO.
 Farm- Richard Peck No. 5

SEC. 26 T. 31 R. 5E
 NE NW NW

Total Depth. 2340'
 Comm. 6-20-61 Comp. 6-25-61
 Shot or Treated.
 Contractor. White & Ellis Drlg.
 Issued. 8-19-61

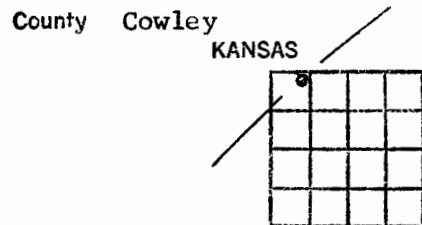

Elevation. 1302' RB

CASING:

8 5/8" 206' cem w/200 sx.

Production. Dry

Figures Indicate Bottom of Formations.

soil	15
lime	206
lime & shale	460
shale & shells	775
sand & shale	830
lime & shale strks	940
shale	985
lime & shale strks	1090
shale	1200
lime & shale strks	1375
shale	1460
lime & shale	1710
shale & sand	1750
shale	1870
shale & lime	1905
sand	1940
sand & shale	1970
shale	2065
shale & lime strks	2100
shale	2295
sand	2340
Total Depth	

TOPS: SCOUT

Iatan	1875
Stalnaker	1888
Lansing	2060
Base Lansing	2294
1st Layton	2294
Base Layton	2340