

FRONT

Form 252-A-5M-9-37

KANSAS

Elk

Sec. 3 Twp. 31 R. 8-E

Well No. #7 Denton (Twin to Dry hole)


Murphy Oil Company

1010 Ft. from N. Line

_____ Ft. from S. Line

_____ Ft. from E. Line

100 Ft. from W. Line

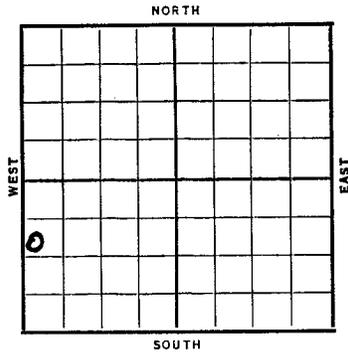

Date	REPORT
1937	
10/13	10" @ 1420'. 6" @ 2240'.
10/29	SD 2600'.
11/5	" "
11/12	" "
11/19	" "
11/26	" "
12/3	8" @ 1956'. K.C. 1958'. S.O. & G 1972-80'. Miss. 2665'. S.O. 2683-89'. 1800' oil in 24 hrs @ 2693-2700'. Sil. 3114'. T.D. 3134'. H.F.W. P.B. to Miss.
12/10	" " "
12/17	" " "
12/24	" " "
12/31	" " "
1938	
1/7	" " "

OVER

Form 26-1M Bks.-2-29

Elk

KANSAS

Map No. 3 Sec. 3 Twp. 31 R. 8E

Well No. 7-A Denton (TWIN)


Murphy Oil Company

Contractor

COMPLETED

SECTION PLAT

SW NW SW
1010 Ft. from N. Line
 _____ Ft. from S. Line
 _____ Ft. from E. Line
100 Ft. from W. Line

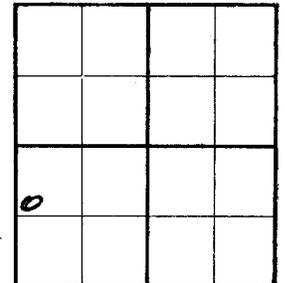

Location _____

Rig up _____

Drilling and Remarks:

P.B. 2700

*13 bbls oil
Per day*

RECORD

Cased 6 in., 2716 ft.

Sand Arb 3114

Gas _____

Oil _____

Total Depth 3134

PRODUCTION *H.F.W.*

1st 24 hrs. Nat. _____

1st 24 hrs. after shot _____

Gas _____ Cu. Ft.

Dry Hole _____

Abandoned _____

Date

JAN 12 1938

19

H. D. Hatfield

Scout

BACK SIDE

1938

1/12

6" @ 2716'.


Arb. 3114'.

T.D. 3134' H.F.W.

P.B. 2700'.

13 bbls. oil per day.

COMPLETED

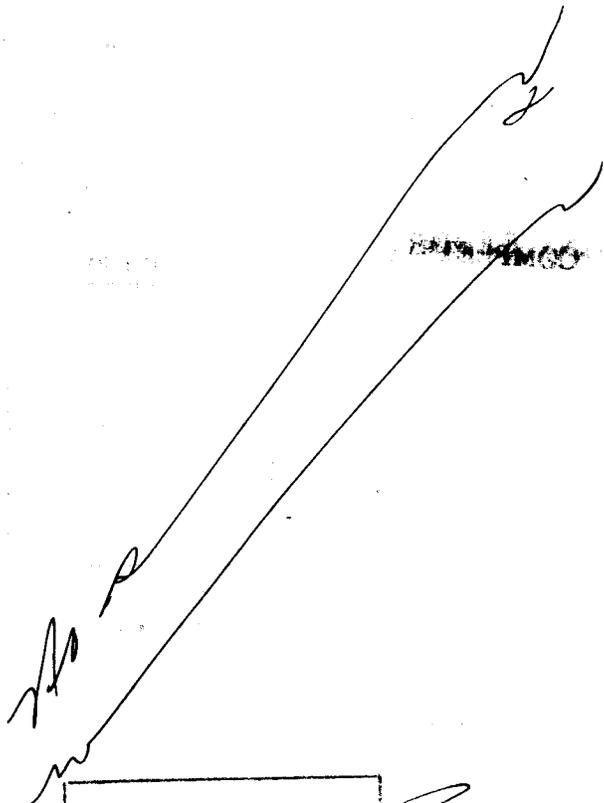

Returned	_____
Cards	_____ <i>Paul</i>
Tracing	_____ <i>J.M.</i>
France Map	_____ <i>J.M.</i>
Scarborough Map	_____ <i>J.M.</i>
Moody Map	_____
Scarborough Plat Book	_____
Moody Plat Book	_____