


Map No. KANSAS Sec. 3 Twp. 31 R. 8
 Well No. 1 Ferguson Farm
E. B. Shaver Company

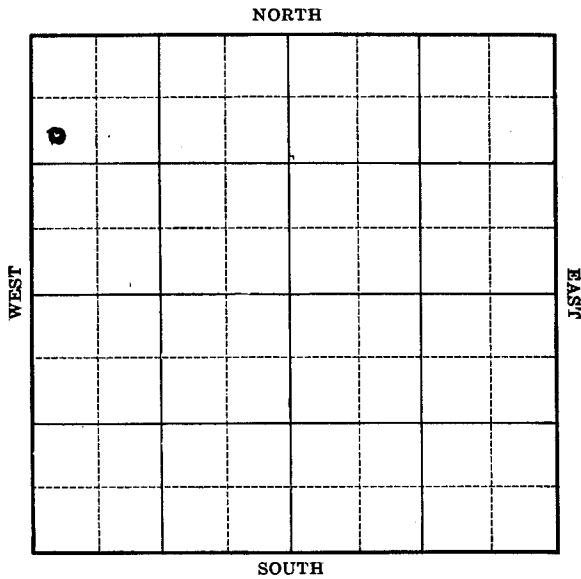

Location _____
 Drilling Remarks _____

Rig Up _____
 Drilling Remarks _____

RECORD			PRODUCTION	
Cased _____ in.	_____ ft.		1st 24 hrs. Nat.	
Sand _____			1st 24 hrs. after shot	
Gas _____			Gas _____ cu. ft.	
Oil _____			Dry Hole _____	
Total Depth _____			Abandoned _____	


Map No. KANSAS Sec. 3 Twp. 31 R. 8
 Well No. 1 Ferguson Farm
E. B. Shaver Company

1070 Ft. from N. Line

_____ Ft. from S. Line

_____ Ft. from E. Line

250 Ft. from W. Line

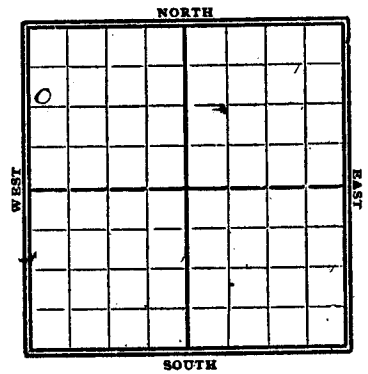

1928

Date

REPORT

7/25 Loc
8/9 Rign up
8/16 Spudg.
8/23 " 200'
8/28 @ 400'
9/4 Rrlg 950'
9/12 fsg 1270
9/19 2 Rrlg 1500'
9/26 " 1855'
10/3 S.D. 2075'
10/10 2 Rrlg 2200'
10/17 " 2641'
10/24 S.D. 2702'
10/31 Top line 2702
 dirlg 2855'
11/7 S.D. 2855'
11/14 _____
11/21 _____
11/28 Top line 2702-
 TD 2855
 Dry & Abandoned

FORM 26 250 BKS. 4-28 WESTERN

K3 KANSAS

MAP NO. 3 SEC. 3 TWP. 31 R. 8

WELL NO. 1

Ferguson

C. B. Shawver

COMPANY

CONTRACTOR

FIRST REPORTS

SECTION PLAT

1070

Ft. FROM N. LINE

Ft. FROM S. LINE

Ft. FROM E. LINE

250

Ft. FROM W. LINE

0			

LOCATION

RECORD

CASED IN. FT.

SAND

GAS

OIL

TOTAL DEPTH

PRODUCTION

1ST 24 HRS. NAT.

1ST 24 HRS. AFTER SHOT

GAS CU. FT.

DRY HOLE

ABANDONED

DATE

JUL 25 1928

CHAS. L. SHERWOOD

SCOUT

FORM 26 250 BKS. 4-28 WESTERN

K3 KANSAS

MAP NO. 3 SEC. 3 TWP. 31 R. 8

WELL NO. 1

Ferguson

C. B. Shawver

COMPANY

CONTRACTOR

COMPLETED

SECTION PLAT

1070

Ft. FROM N. LINE

Ft. FROM S. LINE

Ft. FROM E. LINE

250

Ft. FROM W. LINE

0			

ABANDONED

LOCATION

RECORD

CASED IN. FT.

SAND

GAS

OIL

TOTAL DEPTH

PRODUCTION

1ST 24 HRS. NAT.

1ST 24 HRS. AFTER SHOT

GAS CU. FT.

DRY HOLE

ABANDONED

DATE

NOV 28 1928

CHAS. L. SHERWOOD

192

SCOUT