


Map No. KANSAS Sec. 4 Twp. 31 R. 8
 Well No. 2 Ferguson Farm
Minnetonka Murphy Company

NORTH

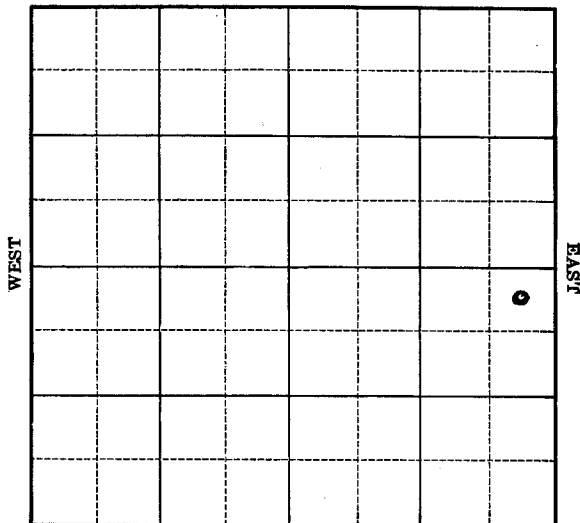

SOUTH

Location
 Drilling Remarks

Rig Up
 Drilling Remarks

RECORD

Cased _____ in. _____ ft.
 Sand _____
 Gas _____
 Oil _____
 Total Depth _____

PRODUCTION

1st 24 hrs. Nat. _____
 1st 24 hrs. after shot _____
 Gas _____ cu. ft.
 Dry Hole _____
 Abandoned _____

Front side

Form 252A-5M-5-28-Mid-West

KANSAS


Map No. _____ Sec. 4 Twp. 31 R. 8
 Well No. 2 Ferguson Farm
Minnetonka Murphy Company

2.50 Ft. from N. Line

_____ Ft. from S. Line

2.50 Ft. from E. Line

_____ Ft. from W. Line

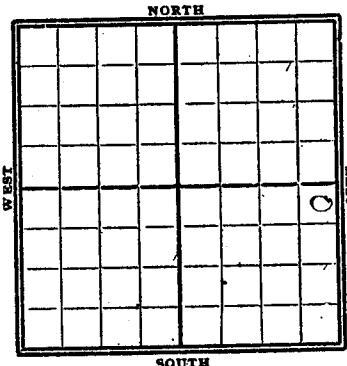

1928

Date

REPORT

7/25 Loc
8/19 Gimber
 8/16 _____ 1929
 8/23 _____ 1/2 _____
 8/28 _____ 1/9 _____
 9/4 _____ 1/16 _____
 9/12 _____ 1/23 _____
 9/19 _____ 1/30 _____
 9/26 _____ 2/6 _____
 10/3 _____ 2/13 _____
 10/10 _____ 2/20 _____
 10/17 _____ 2/27 _____
 10/24 _____ 3/6 _____
 10/31 _____ 3/13 _____
 11/7 _____ 3/20 _____
 11/14 _____ 3/27 _____
 11/21 _____ 4/3 _____
 11/28 _____ 4/10 _____
 12/5 _____ 4/17 _____
 12/12 _____ 4/24 _____
 12/19 _____ 5/1 Regroup
 12/26 _____ (over)

Back side

5/8- Spud 150'
5/15- Drly 400'
5/22- " 660'
5/29- SD 1040'
6/5- Drly 1200'
6/12- T.D. 1200'
U/R 10"- 1150'
6/19- drly 1575'
6/26- " 1820'
7/2- sand 1955-75'
Pay 1955-63'
T.D. 1975'
100-bbls oil
Pomp.

3 KANSAS SEC. 4 TWP. 31 R. 8

WELL No. 2 Ferguson
Minnehoma & Murphy COMPANY

CONTRACTOR

FIRST REPORTS

750 FT. FROM N. LINE

FT. FROM S. LINE

750 FT. FROM E. LINE

FT. FROM W. LINE

SECTION PLAT

LOCATION

RIG UP

DRILLING AND REMARKS:

RECORD

CASED IN. FT.

SAND

GAS

OIL

TOTAL DEPTH

PRODUCTION

1ST 24 HRS. NAT.

1ST 24 HRS. AFTER SHOT

GAS Cu. Ft.

DRY HOLE

ABANDONED

DATE

JUL 25 1928

CHAS. L. SHERWOOD

SCOUT

3 KANSAS SEC. 4 TWP. 31 R. 8

WELL No. 2 Ferguson
Minnehoma & Murphy COMPANY

CONTRACTOR

COMPLETE

750 FT. FROM N. LINE

FT. FROM S. LINE

750 FT. FROM E. LINE

FT. FROM W. LINE

SECTION PLAT

Location

Rig up

Drilling and Remarks:

Pay 1955-63
100 Bbs.

RECORD

Cased in. ft.

Sand 1955-1975

Gas

Oil

Total Depth 1975

PRODUCTION

1st 24 hrs. Nat.

1st 24 hrs. after shot

Gas Cu. Ft.

Dry Hole

Abandoned

Date

7/2

1929

CHAS. L. SHERWOOD

Scout