

Elk KANSAS


SEC. 10 TWP. 31 R. 8E

WELL NO. #1 Denton FARM

COMPANY Murphy Oil & Pacific Western

CONTRACTOR

Grand Summitt Pool

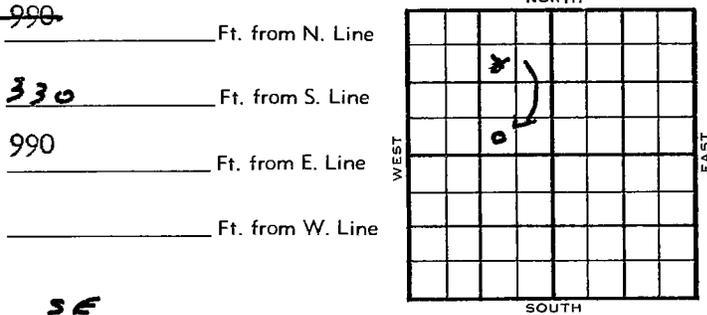

SE SW NE NW

1955	ELEVATION	REPORT
3/9	Spud 2-22-55 Sand 1868' DST 1870'-85' opn 1/2 hr, rec 275' Mud 400# DST 1923'-33' opn 20 min, rec 4' Mud 395# K' 1979' TD 2026' 7" @ 1991'	
4/13	Spud 2-22-55 Oil well TD 2026 Sand 1868 DST 1870-85 open 1/2 hr rec 275' mud, 400# DST 1923-33 open 20 min, rec 4' mud. 395# KC 1979 TD 2026 7" @ 1991 DP 2026 2000 A Comp. 32 BOPD	
<b>COMPLETED</b>		

DX-78

SCOUT TICKET DX-201

Kansas


SEC. 10 TWP. 31 R. 8E

WELL NO. #1 Denton FARM

COMPANY Murphy Oil & Pacific Western

CONTRACTOR

CORRECTION

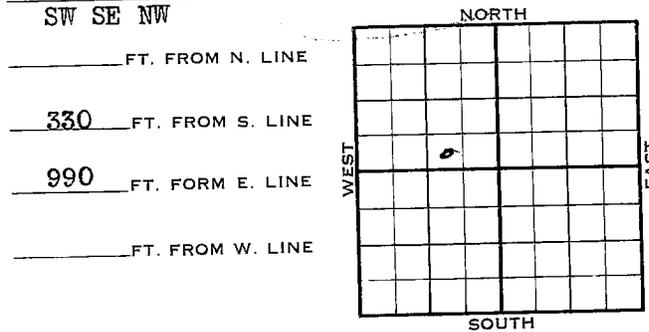

Elk County

<input type="checkbox"/> LOCATION <input type="checkbox"/> RIG UP DRILLING AND REMARKS:  Reported SW NE NW	RECORD	CASED IN., FT.
		SAND
PRODUCTION	GAS	
	OIL	
	TOTAL DEPTH	
	1ST 24 HRS. NAT.	
		1ST 24 HRS. AFTER SHOT
		GAS CU. FT.
		DRY HOLE
		ABANDONED
DATE	SCOUT	
MAR 28 1955	FABEN	

