Form 26—1M Bks.—9-28

Elk

Map No. KANSAS Sec. 10 Twp. 31 R. 8 E

3

Well No. 1 Denton

Ramsey Oil Co. Company

Contractor

FIRST REPORTS

330 Ft. from N. Line

Ft. from S. Line

990 Ft. from E. Line

Ft. from W. Line

SECTION PLAT

	o		

Location

Rig up Roly

Drilling and Remarks:

RECORD

Cased in., ft.

Sand

Gas

Oil

Total Depth

PRODUCTION

1st 24 hrs. Nat.

1st 24 hrs. after shot

Gas Cu. Ft.

Dry Hole

Abandoned

Date OCT 30 1929 192

CHAS. L. SHERWOOD Scout

Form 26—1M Bks.—9-28

Elk

Map No. KANSAS Sec. 10 Twp. 31 R. 8

3

Well No. 1 Denton

Ramsey Oil Co. Company

Contractor

COMPLETE

330 Ft. from N. Line

Ft. from S. Line

990 Ft. from E. Line

Ft. from W. Line

ABANDONED

SECTION PLAT

	o		

Location

Rig up

Drilling and Remarks:

top lime 2443

RECORD

Cased in., ft.

Sand

Gas

Oil

Total Depth 2669

PRODUCTION

1st 24 hrs. Nat.

1st 24 hrs. after shot

Gas Cu. Ft.

Dry Hole ✓

Abandoned ✓

Date APR 9 1930 192

CHAS. L. SHERWOOD Scout

Form 252A—5M—10-26—24951

Elk

Map No. KANSAS Sec. 10 Twp. 31 R. 8E

Well No. 1 Denton Farm

Ramsey et al Company

330 Ft. from N. Line

Ft. from S. Line

990 Ft. from E. Line

Ft. from W. Line

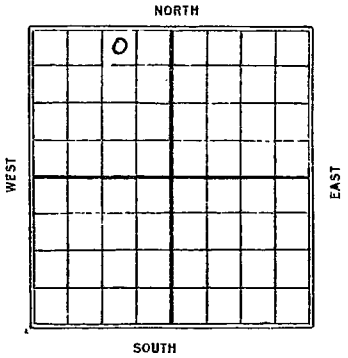

1929

Date	REPORT
10/30	Loc.
11/6	Rigging up.
11/13	Spudded 50'
11/20	Drlg 425'
11/27	" " 890'
12/4	SD 990'
12/11	Drlg 1415'
12/23	VIRJ 10" - 1415'
12/30	—
1930	
1/8	—
1/15	Sand 1956-71' SD
	1500' oil in hole
1/22	—
1/29	—
2/4	—
2/11	—
2/19	20 bbls oil - may
	deepen.
2/26	Top lime 2643' Rng 6"
3/5	T.D. 2661' ~~400' Oil~~ -
	S.D.

3/12 TD 2663

3/19 ----------

3/26 ----------

4/2 ----------

4/9 Top lime 2643, TD 2669, Abandon