

Elk


KANSAS

SECTION 22 TOWNSHIP 31S RANGE 8E

WELL NO. #1 Hutchinson

COMPANY R.L. Mendenhall

NORTH C NW NE

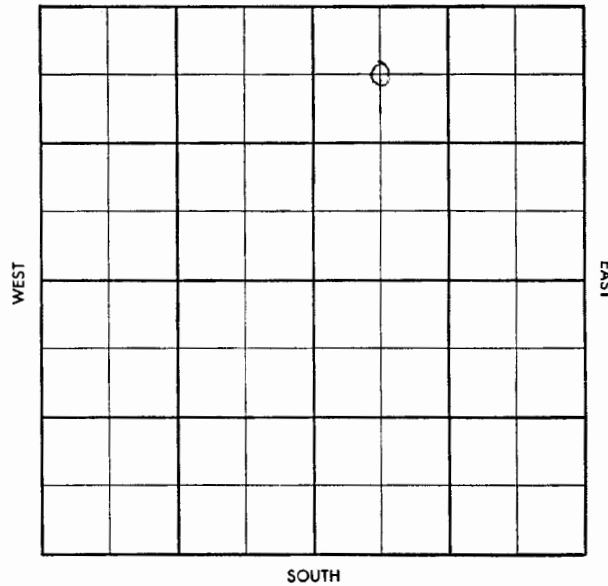

WILDCAT

S-513-B

County Elk Elev. _____
 Sec. 22 Twp. 31- Rge. 8E
 Company R. L. Mendenhall
 Farm Name Hutchinson No. 1

TOPS	DEPTH	LOG	DATUM
Anh.			
Tp.			
H.			
Tr.			
Dg.			
B.L.			
L.			
K.C.			
B.K.C.			
Ce.			
C.			
M.			
M.			
K.			
Mz.			
Mq.			
V.			
S.			
S.			
A.			
R.			
Pf.			
G.			
T.D.			

Loc. in Sec. 300' NE of
C NW N E

Geol. _____
 Contr. _____

Pool Wildcat

FIRST REPORT
 AUG 6 '58

Date Comm. (Carter - Ac & DHM)
M I R T

S-513-B

County Elk Elev. 13265
 Sec. 22 Twp. 31- Rge. 8E
 Company R. L. Mendenhall
 Farm Name Hutchinson No. 1

TOPS	DEPTH	LOG	DATUM
Anh.			
Tp.			
H.			
Tr.			
Dg.			
B.L.			
L.			
K.C.			
B.K.C.			
Ce.			
C.			
M.			
K.			
Mz.			
Mq.			
V.			
S.			
S.			
A.			
R.			
Pf.			
G.			
T.D.			

Loc. in Sec. 300' NE of
C NW N E

Geol. _____
 Contr. _____

Pool Wildcat

ABANDONED
 AUG 27 '58

Date Comm. 8-5-58 (Carter - Ac & DHM)
M I R T AUG 13 '58 8" 60/45

42115 AUG 20 '58 125' 2905-10
40" 90' M FPO BHP 495/20
PROD 2965-70 NOS 42980
AUG 27 '58 TD 3001 Elec Log 3000
D48