

FORM 51


Cowley

KANSAS

Section 1 Township 32 Range 5E

Well No. #1 Lewis

Company Helmerich & Payne

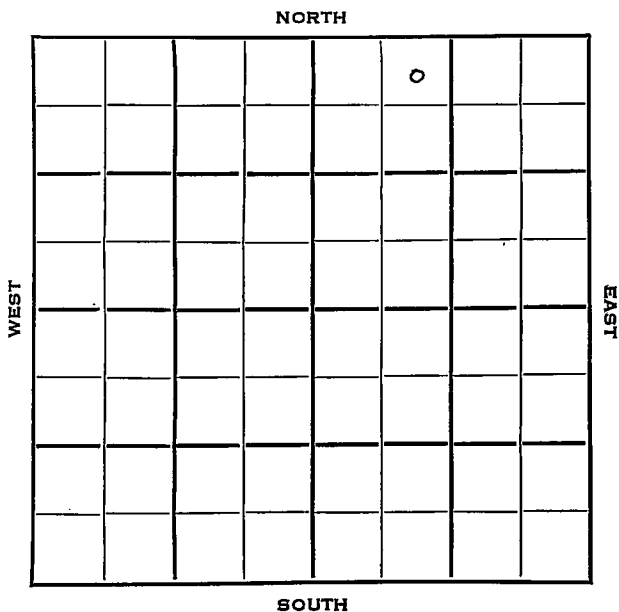

Cowley

KANSAS ✓

1

32

5E

Sec. _____ Twp. _____ R. _____

#1 Lewis

Well No. _____ Farm _____

Helmerich & Payne

Company _____

Contractor _____

330

Ft. from N. Line


Ft. from S. Line

Ft. from E. Line

990

Ft. from W. Line

NE NW NE

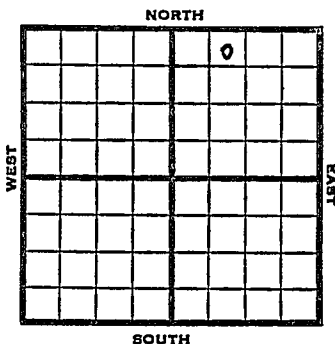

1953

Elev. 1370'

REPORT

2/4 Spud 2-1-53
10" @ 142'

2/18 Spud 2-1-53
D & A TD 3007' 10" @ 142
sd 2976
DST 2974-3006 open 3/4 hr. rec 20'
VSOCM & SSO Off TD 3006'
5" @ 2978 Bart 2978' DD 3007
Oil-frac. HFW
D & A

ABANDONED

