


Section 10 Township 32 Range 7 E

Well No. #9 Beamer

Company Petroleum Management

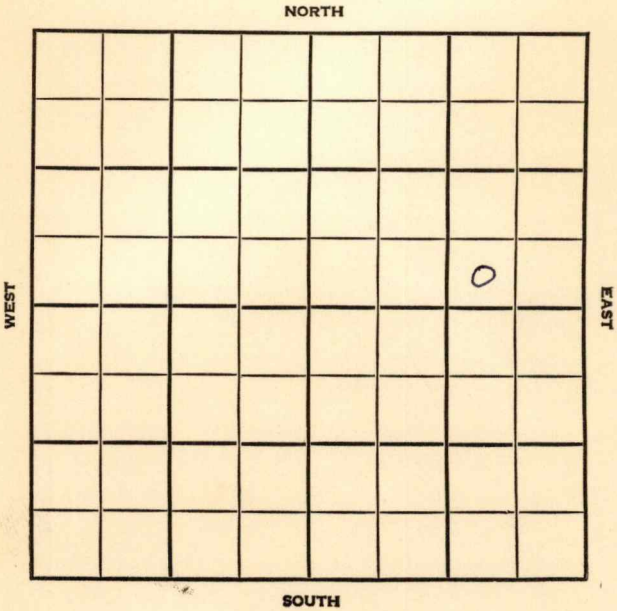

Cowley

KANSAS


SEC.	10	TWP.	32	R.	7E
------	----	------	----	----	----

WELL NO. #9 Beamer FARM

COMPANY Petroleum Management

CONTRACTOR Krisswell School Creek

\_\_\_\_\_ Ft. from N. Line  
 \_\_\_\_\_ Ft. from S. Line  
 \_\_\_\_\_ Ft. from E. Line  
 \_\_\_\_\_ Ft. from W. Line

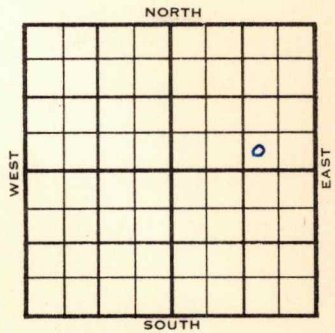

SW SE NE

1955	ELEVATION 1402 DF 1405 RB	REPORT
------	---------------------------------	--------

8/17 Comm 8-8-55  
 U Layton 2086  
 L. Layton 2135  
 8" @ 70/50  
 TD 2165  
 5" @ 2164/165  
 8-24 CO to 2156,24/ 2138-44, frac, S & F/  
 5 boph, 25% wtr., Comp. 25 bopd, 25% wtr  
 Dg. U.Layton, 2086, 681, B.L. L.Layton  
 2135, 730, T.D. 2165

COMPLETED

County Cowley Elev. 1405 RB  
 Sec. 10 Twp. 32 Rge. 7E  
 Company Petroleum Management  
 Farm Name Beamer No. 9

TOPS	DEPTH	LOG	DATUM
Anh.			
Tp.			
H.			
Tr.			
Dg. <u>U. Layton</u>	<u>2086</u>		
Bl. <u>L. Layton</u>	<u>2135</u>		
L.			
K.C.			
B.K.C.			
Ce.			
C.			
M.			
M.			
K.			
Mz.			
Mq.			
V.			
S.			
S.			
A.			
R.			
Pe.			
G.			
T.D.			

Loc. in Sec. SW SE NE

Geol. \_\_\_\_\_

Contr. Krisswell

Pool \_\_\_\_\_

School Creek

FIRST REPORT  
AUG 17 1955

Date Comm. 8-8-55  
8" @ 70/50 TD 2165 5" @ 2164/165

Co.  
Lse.  
No.  
Sec.  
T.  
R.

1402 DF  
1405 RB

County Cowley Elev. \_\_\_\_\_  
 Sec. 10 Twp. 32 Rgs. 7E  
 Company Petroleum Management  
 Farm Name Beamer No. 9

TOPS	DEPTH	LOG	DATUM
Anh.			
TP.			
H.			
Tr.			
Dg. <u>U. Layton</u>	<u>2086</u>		<u>681</u>
Bl. <u>L. "</u>	<u>2135</u>		<u>730</u>
L.			
K.C.			
B.K.C.			
Ce.			
C.			
M.			
M.			
K.			
Mz.			
Me.			
V.			
S.			
S.			
A.			
R.			
Pe.			
G.			
T.D.	<u>2165</u>		

Loc. in Sec. SW SE NE  
 Geol. \_\_\_\_\_  
 Contr. \_\_\_\_\_  
Krisswell  
 Pool \_\_\_\_\_  
School Creek

COMPLETE

Date Comm. 8-8-55 AUG 24 1955  
8" @ 70/50 5" @ 2164/165 CO to 2156  
2 1/2" 2138-1/4 frac S & F/ 5 boph 25% wtr.  
Comp. 25 bopd 25% wtr.

Co.  
Lse.  
No.  
Sec.  
T.  
R.