


Section 10 Township 32 Range 7E

Well No. 1 Davis

Company Fred Ayesch

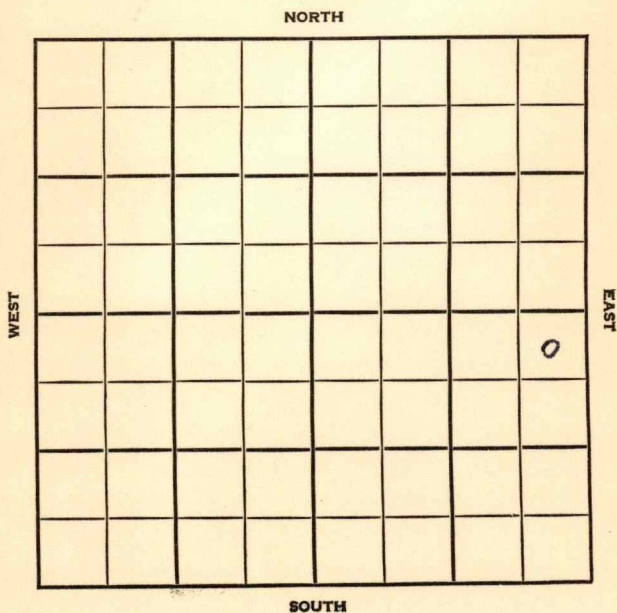

Cowley

KANSAS

SEC.	TWP.	R.
10	32	7E ✓

WELL NO. _____

COMPANY #1 Davis FARM

CONTRACTOR Fred Ayesh

Kriswell


School Creek Pool NORTH

330 Ft. from N. Line

_____ Ft. from S. Line

330 Ft. from E. Line

_____ Ft. from W. Line

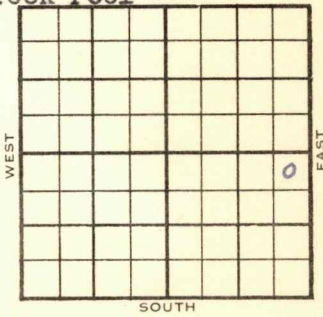

NE NE SE

	ELEVATION	REPORT
1954	11404'	

5/12 Spud 5-9-54
8" @ 60'
Drlg1050'

5/26 Spud 5-9-54 Oil well TD 2170
8" @ 60 Layton 2114 TD 2170
4 1/2" @ 2169 44/2131-42 frac.
Comp. 25 BOPD

COMPLETED

