

Cowley

KANSAS

SECTION 10 TOWNSHIP 32S RANGE 7E

WELL NO. #1 Overman


COMPANY Cymco Petroleum NW NE SW

NORTH

~~SW NE SW~~

WEST

EAST

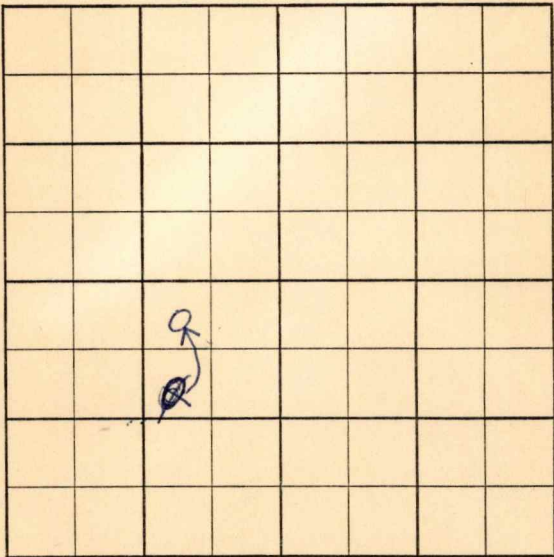

SOUTH

S-513-B

CORRECTION

Twp. ~~10~~ Pool ~~1~~Co. ~~1~~ Facet ~~1~~

County Cowley Elev. 1381 OF 1394
 Sec. 10 Twp. 32 Rge. 7E
 Company Cymco Petroleum
 Farm Name Overman No. 1

TOPS	DEPTH	LOG	DATUM	Loc. in Sec.
Anh. <u>5701</u>	<u>1686</u>			<u>SW NE SW</u>
Tp. <u>Log</u>	<u>2060</u>			<u>nr ne sw</u>
H.				
Tr.				
Dg.				
B.L.				
L.				
K.C.	<u>2251</u>			Geol. <u>J. Craig</u>
B.K.C. <u>clm</u>	<u>2395</u>			Contr. <u>Gearhart</u>
Ce. <u>OSW</u>	<u>2535</u>			<u>Canady</u>
C. <u>Bart</u>	<u>2800</u>			
M.	<u>2873</u>			Pool
M.				
K.				
Mz.				
Mq.				
V.				
S.				
S.				
A.				
R.				
Pf.				
G.				
T.D.	<u>2894</u>			

COMPLETE

JUL 9 '58

Date Comm. 5-29-588" @ 125, Drlg. 1520 JUN 11 '58 5" 2893JUN 18 '58 DST 2060 - 2125 60"

90' gen BHP 490/30" end
 2404-40 full rec all sd 18' sd

sgas 18" sd 650 JUN 25 '58 JUL 2 '58

JUL 9 '58 4/2804-10 pop p 76130 p d + 6 B a p d

⊕

Top. ~~XXXXXX~~ Pool ~~XXXXXX~~

Co. ~~XXXXXX~~ Facet ~~XXXXXX~~

S-513-B

County Cowley Elev. _____
Sec. 10 Twp. 32 Rge. 7E
Company Cymco Petroleum
Farm Name Overman No. 1

TOPS	DEPTH	LOG	DATUM
Anh.			
Tp.			
H.			
Tr.			
Dg.			
B.L.			
L.			
K.C.			
B.K.C.			
Ce.			
C.			
M.			
M.			
K.			
Mz.			
Mq.			
V.			
S.			
S.			
A.			
R.			
Pf.			
G.			
T.D.			

Loc. in Sec. _____

SW NE SW

Geol. J. Craig

Contr. Gearhart

Canady

Pool _____



Date Comm. 5-29-58
8" @ 125, Drlg. 1520

Co.

Lse.

No.

Sec.

T.

R.