

Cowley


KANSAS

SECTION 11 TOWNSHIP 32S RANGE 7E

WELL NO. #1 Miller

COMPANY Nate Appleman SE SE NE

NORTH SW SW NE

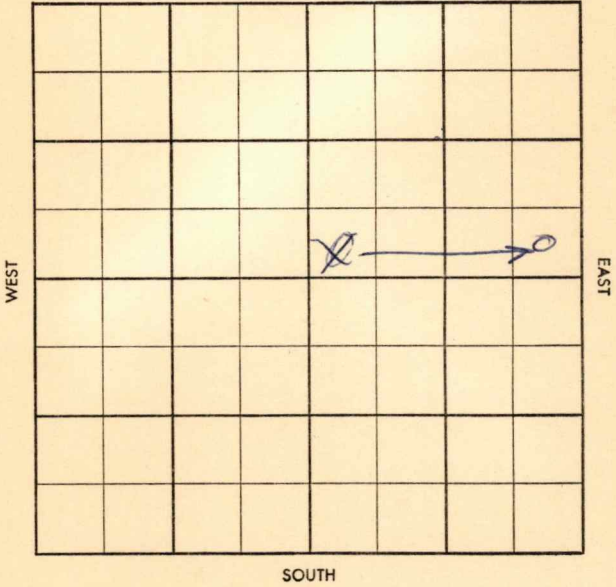

~~Top~~ ~~Prod~~  
~~30~~

S-513-B

County Cowley Elev. \_\_\_\_\_  
 Sec. 11 Twp. 32 Rge. 7E  
 Company Nate Appleman  
 Farm Name Miller No. 1

TOPS	DEPTH	LOG	DATUM
Anh.			
<del>Stal</del>	1717		
H.			
<del>Layton</del>	2093		
Dg.			
<del>Ctg Gr</del>	2146		
L.			
K.C.			
B.K.C.			
Ce.			
C.			
M.			
M.			
K.			
Mz.			
Mq.			
V.			
S.			
S.			
A.			
R.			
Pf.			
G.			
T.D.			

Loc. in Sec. SW SW NE

Geol. \_\_\_\_\_

Contr. \_\_\_\_\_

Pool \_\_\_\_\_

APR 30 1938  
**FIRST REPORT**

Date Comm. \_\_\_\_\_ (Texas - FO)  
 DST 2138-55 open 1 hr, rec. 60' gas, 47' sli  
 ocm, BHP 620-485, FP 30-45, Drlg. Ahead.  
 Cottage Grove 2146.

Co. \_\_\_\_\_  
 Lse. \_\_\_\_\_  
 No. \_\_\_\_\_  
 Sec. \_\_\_\_\_  
 T. \_\_\_\_\_  
 R. \_\_\_\_\_

Twp. ~~Pool~~

Co. ~~Facet~~

**CORRECTION**

S-513-B

County Cowley Elev 14100 F 1413 AB  
 Sec. 11 Twp. 32 Rge. 7E  
 Company Nate Appleman  
 Farm Name Miller No. 1

TOPS	DEPTH	LOG	DATUM
Anh. <del>Stal</del>	1717		
H. <del>Layton</del>	2093		
Dg. <del>Ctg Gr</del>	2146		
L.			
K.C.			
B.K.C.			
Ce.			
C.			
M.			
M.			
K.			
Mz.			
Mq.			
V.			
S.			
S.			
A.			
R.			
Pf.			
G.			
T.D.	<u>2205</u>		

Loc. in Sec. \_\_\_\_\_

~~SW SW NE~~  
**SE SE NE**

Geol. \_\_\_\_\_

Contr. \_\_\_\_\_

Pool \_\_\_\_\_

**ABANDONED**

~~0-70~~

JUN 3 '58

Date Comm. 4-24-58 (Texas - FO)

DST 2138-55 open 1 hr, rec. 60' gas, 47' sli ocm, BHP 620-485, FP 30-45, Drlf. Ahead.

Cottage Grove 2146. MAY 7 '58 8" 128

5" 2205 MAY 14 '58 MAY 21 '58 24/2148

-54 SW 550 ~~FB~~ 59 36/2123

-34 SI FU 345' DW Sdk Oil

+ to Enac MAY 23 '58 JUN 3 '58 HFW

D6A

Co. \_\_\_\_\_  
Lse. \_\_\_\_\_  
No. \_\_\_\_\_  
Sec. \_\_\_\_\_  
T. \_\_\_\_\_  
R. \_\_\_\_\_