

Cowley


KANSAS

FORM 51

Section 11 Township 32 Range 7E

Well No. #2 Miller

Company Kriswell Drlg.

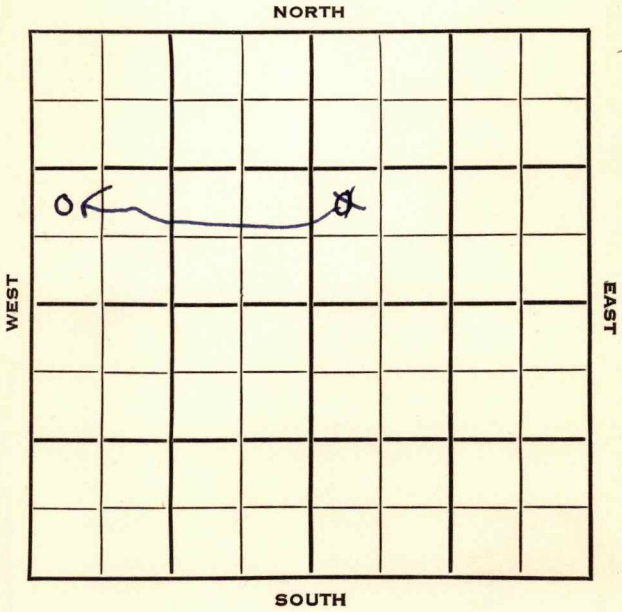

Cowley

KANSAS


| | | |
|------|------|----|
| SEC. | TWP. | R. |
| 11 | 32 | 7E |

WELL NO. #2 Miller FARM

COMPANY Kriswell Drlg.

CONTRACTOR Kriswell

_____ Ft. from N. Line
 990 _____ Ft. from S. Line
 _____ Ft. from E. Line
 330 _____ Ft. from W. Line

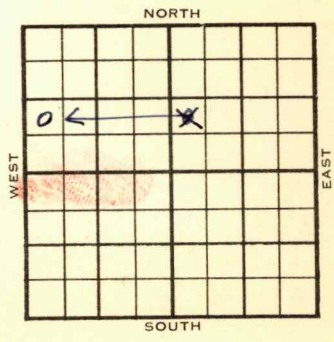

NW SW NW
~~NW SW NE~~

1954 ELEVATION 2123' REPORT

1/13 Spud 1-5-54
 8" @ 66'
 Layton 2123',
 Cored 2127'-69'
 Rec 42'
 5" @ 2184'
 TD 2185'

2/24 Spud 1-5-54
 Oil Well
 TD 2185'
 8" @ 66'
 Layton 2123'
 TD 2185'
 5" @ 2184'
 CO to 2170'
 36/ 2156-65 sd-oil-frac F/ 40 boph
 12 hr.
 Comp. 25 bopd.

COMPLETED

Map No. _____ Sec. 11 Twp. 32 R. 7E

Well No. 2 Miller

Kriswell Drlg. Company

CORRECTION Contractor

NW SW NW

SECTION PLAT

| | | | |
|---|--|--|--|
| | | | |
| o | | | |
| | | | |
| | | | |

_____ Ft. from N. Line

990 Ft. from S. Line

_____ Ft. from E. Line

330 Ft. from W. Line

Cowley County

Location _____

Rig up _____

Drilling and Remarks:

Reported
NW SW NE

RECORD

Cased _____ in., _____ ft.

Sand _____

Gas _____

Oil _____

Total Depth _____

PRODUCTION

1st 24 hrs. Nat. _____

1st 24 hrs. after shot _____

Gas _____ Cu. Ft.

Dry Hole _____

Abandoned _____

Date

JAN 20 1954

19

J. G. McGEHEE

Scout

