


Section 11 Township 32 Range 7E

Well No. 3 Miller

Company Fred Ayesch

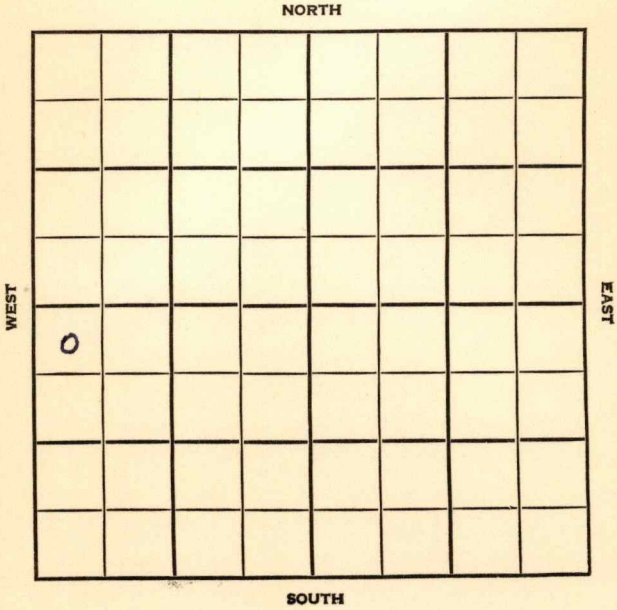

SEC.	TWP.	R.	
11	32	7E	✓


WELL NO. #3 Miller FARM

COMPANY Fred Ayesh

CONTRACTOR Krisswell

School Creek Pool

330 Ft. from N. Line
 _____ Ft. from S. Line
 _____ Ft. from E. Line
 330 Ft. from W. Line

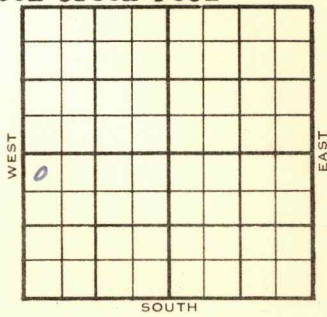

NWNW SW

1954	ELEVATION	REPORT
	1413'	

5/12 Spud 5-4-54
 8" @ 60'
 Hogshooter Lime 2071', Layton 2125'
 TD 2185'
 5" @ 2184'
 WOC.

5/26 Spud 5-4-54 Oil well TD 2185
 8" @ 60 Hogshooter lime 2071
 Layton 2125 TD 2185 5" @ 2184
 48/2152-64 frac. F/oil & wtr.
 Comp. 30 BOPD 20% wtr.

COMPLETED

County **Cowley** State **Kansas**
 Sec. **11** (Blk. Twp.) **32** (Sur. Rge.) **7E** Map No.
 Operator **Fred Ayesh**
 Well No. **3** Farm **Miller**
 Elev. **1413** Location **NW NW SW**

330 Ft. From **N** Line **SW**
330 Ft. From **W** Line Quarter
 Ist. Report **MAY 1 2 1954**
 Completion _____
 Remarks **Krisswell - Contr.**
 Spudding Date **5-4-54**

Drlg. Data **School Creek Pool**
8" @ 60 Hogshooter line 2071 Layton 2125
TD 2185 5" @ 2184 WOC

County Cowley State Kansas

Sec. 11 (Blk. 32) (Sur. 7E) Map No.

Operator Fred Ayesch

Well No. 3 Farm Miller

Elev. 1413 Location NW NW SW

o					

COMPLETE

330 Ft. From N Line SW

330 Ft. From W Line Quarter

1st. Report

Completion MAY 26 1954

Remarks School Creek Pool

Krisswell - Contr.

Spudding Date 5-4-54

Drlg. Data Oil well TD 2185

8" @ 60 Hogshooter lime 2071 Layton 2125

TD 2185 5" @ 2184 48/ 2152-64 frac

F/ oil & wtr. Comp. 30 bopd 20% wtr.

J. G. McGEHEE