

Cowley KANSAS

DX 78-1

Section 11 Township 32 Range 7E

Well No. 4 Miller

Company Fred Ayesh

NORTH

0							

WEST

EAST

SOUTH

Cowley KANSAS

SEC. 11 TWP. 32 R. 7E

WELL NO. 4 Miller FARM

COMPANY Fred Ayesh

CONTRACTOR

N. CreekPool


990 Ft. from N. Line

Ft. from S. Line

Ft. from E. Line

330 Ft. from W. Line

SW MW NW

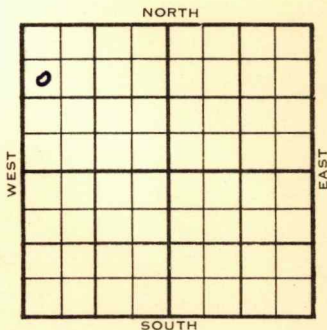

1954

ELEVATION

1415

REPORT

7/21

Spdg 7-7-54

8" @ 80

Hogshooter 2066 Layton 2132

TD 2184

4" @ 2183 CO to 2150

56/ 2133-47 frac

8/4

Spdg 2184

Oil well

TD 2184

8" @ 80

Hogshooter 2066 Layton 2132

TD 2184

4" @ 2183 CO to 2150 56/ 2133-47

frac F/ 45 boph Comp. 25 bopd

COMPLETED

County **Cowley** State **Kansas**

Sec. **11** (Blk. Twp.) **32** (Sur. Rge.) **7E** Map No.

Operator **Fred Ayesh**

Well No. **4** Farm **Miller**

Elev. **1415** Location **SW NW NW**

0					

990 Ft. From **N** Line **NW**

330 Ft. From **W** Line **Quarter**

Ist. Report **JUL 21 1954**

Completion

Remarks

FIRST REPORT

Spudding Date **7-7-54**

Drig. Data **N. School Creek Pool**

8" @ 80 Hogshooter 2066 Layton 2132

TD 2184 4" @ 2183 CO to 2150

56/ 2133-47 frac

County Cowley State Kansas

Sec. 11 (Blk. 32 (Twp. 7E (Sur. Rge.) 7E Map No.

Operator Fred Ayesh

Well No. 4 Farm Miller

Elev. 1415 Location SW NW NW

0					

990 Ft. From N Line NW

330 Ft. From W Line Quarter

1st. Report

Completion AUG 4 1954

Remarks N. School Creek Pool

Spudding Date 7-7-54

Drlg. Data Oil well TD 2184

8" @ 80 Hogshooter 2066 Layton 2132

TD 2184 4" @ 2183 CO to 2150

56/ 2133-47 frac F/ 45 boph

Comp. 25 bopd