


DX 78-1

Section 11 Township 32 Range 7E

Well No. m 5 Miller

Company Fred Ayesh

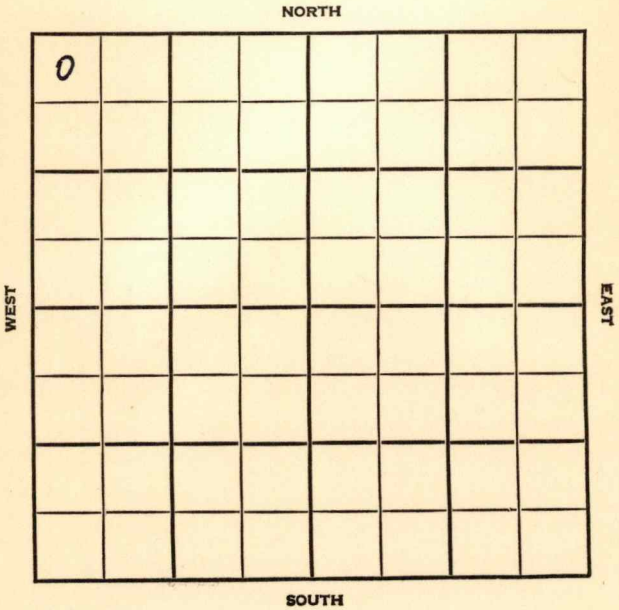

**Cowley KANSAS**


SEC.	TWP.	R.
11	32	7E

WELL NO. \_\_\_\_\_  
 COMPANY 5 Miller FARM

CONTRACTOR Fred Ayesh

**N. School Creek Pool**

330 Ft. from N. Line  
 \_\_\_\_\_ Ft. from S. Line  
 \_\_\_\_\_ Ft. from E. Line  
330 Ft. from W. Line

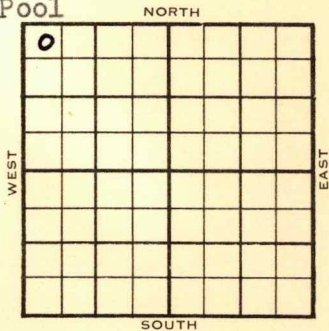

NW NW NW

	ELEVATION	REPORT
1954	1416	

7/23 Spdg 7-13-54  
 8" @ 80

8/4 Spdg 7-13-54  
 Oil well  
 TD 2179  
 8" @ 80  
**Hogshooter 2065 Layton 2126**  
 TD 2179  
 5" @ 2175  
 60/ 2128-48  
 sd-frac F/ 35 boph Comp. 25 bopd

**COMPLETED**

County Cowley State Kansas

Sec. 11 (Blk.) 32 (Sur.) 7E Map No.

Operator Fred Ayesh

Well No. 5 Farm Miller

Elev. 1416 Location NW NW NW

0									

330 Ft. From N Line NW

330 Ft. From W Line Quarter

1st. Report

Completion 4UG 4 1954

Remarks N. School Creek Poo

Spudding Date 7-13-54

Drig. Data Oil well TD 2179

8" @ 80 Hogshooter 2065 Layton 2126

TD 2179 5" @ 2175 60/ 2128-48

sd-frac F/ 35 boph Comp. 25 bopd

