


Section 11 Township 32 Range 7 E

Well No. # 6 Miller

Company Ayesch Oil

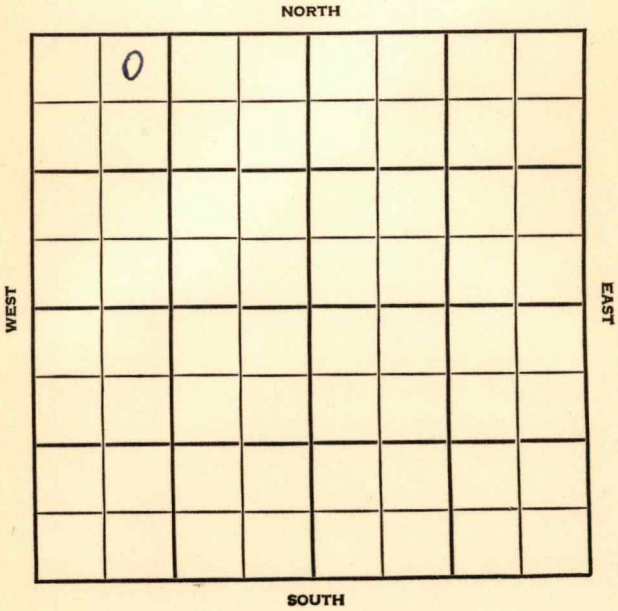

SEC.	TWP.	R.
11	32	7E


WELL NO. #6 Miller FARM

COMPANY Ayesch Oil

CONTRACTOR Kriswell

School Creek Pool

330 Ft. from N. Line
 Ft. from S. Line
 Ft. from E. Line
 990 Ft. from W. Line

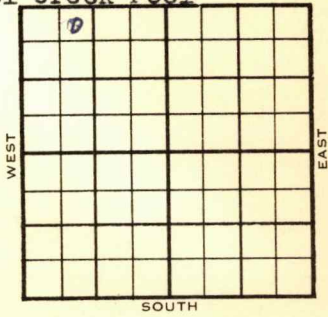

NE NW NW

	ELEVATION	REPORT
1955	1409'	
3/16	Spud 3-11-55 8" @ 191'	
4/27	Drlg. 1837' Spud 3-11-55 Oil well TD 2187 8" @ 191 KC 2078 Layton 2088 TD 2187 4 1/2" @ 2187 16/2139-43 Frac. F/10 BOPH 1 BW Comp. 25 BOPD	
	COMPLETED	

County **Cowley** State **Kansas**

Sec. **11** (Blk.) **32** (Sur.) **7E** Map No.

Operator **Ayesch Oil**

Well No. **6** Farm **Miller**

Elev. Location **NE NW NW**

0					

330 Ft. From **N** Line **NW**

990 Ft. From **W** Line **Quarter**

1st. Report **MAR 16 1955**

Completion

Remarks

Kriswell - Contr.

Spudding Date **3-11-55**

Drlg. Data **School Creek Pool**

8" @ 191 drlg. 1337

FABEN GILSTRAP

County Cowley State Kansas

Sec. 11 (Blk. 32 (Sur. 7E (Twp. 7E Map No. _____)

Operator Ayesch Oil

Well No. 6 Farm Miller

Elev. 1409 Location NE NW NW

0							

330 Ft. From N Line NW
 990 Ft. From W Line Quarter

1st. Report _____

Completion APR 27 1955

Remarks School Creek Pool
Kriswell - Contr.

Spudding Date 3-11-55

Drlg. Data Oil well TD 2187

8" @ 191 KC 2078 Layton 2088

TD 2187 4 1/2" @ 2187 16/ 2139-43

frac F/ 10 boph 1 bw

Comp. 25 bopd

FABEN GILSTRAP