12-55

| | |
|---|---|
| STATE: Kansas | COMPANY: Mallonee Drlg. |
| COUNTY: Cowley | FARM: Ledgerwood 1 — WELL NO. |
| BLOCK | SURVEY |
| SEC. 19 | |
| T. 32 — R. 7E | TOTAL DEPTH 2913 |
| | SW-NW-NE |
| | COMMENCED |
| | COMPLETED |
| | REMARKS |
| ALTITUDE 1247 | |
| PRODUCTION D&A | |

CASING RECORD

SHOT — QUARTS — BETWEEN
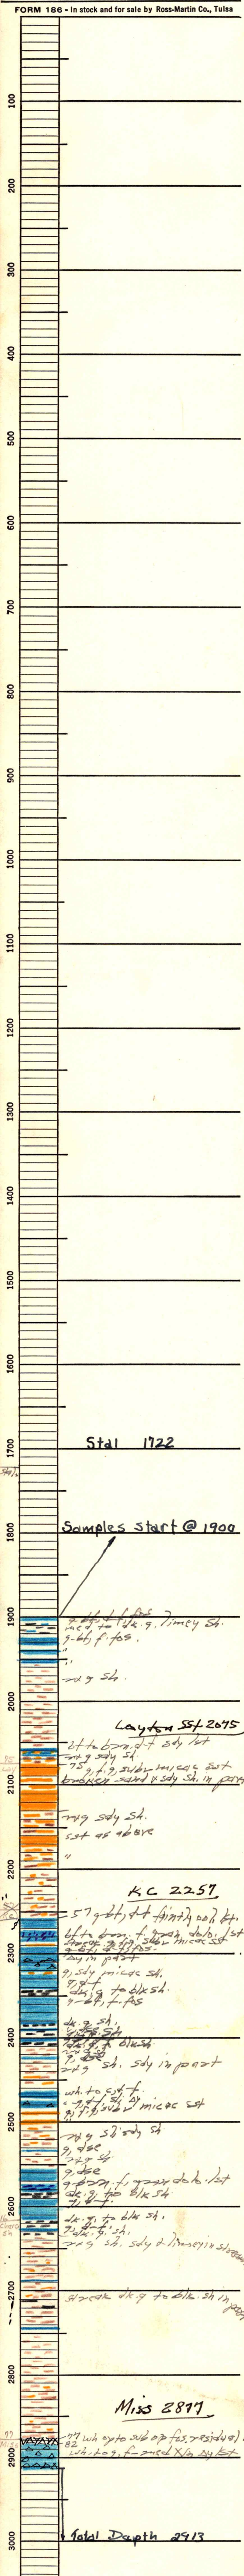
FORM 186 - In stock and for sale by Ross-Martin Co., Tulsa