

17-32-2E *ZUC*

SIDE ONE

STATE CORPORATION COMMISSION OF KANSAS
OIL & GAS CONSERVATION DIVISION
WELL COMPLETION OR RECOMPLETION FORM
ACO-1 WELL HISTORY
DESCRIPTION OF WELL AND LEASE

Operator: License # 03553
Name CITATION OIL & GAS CORP.
Address 16800 Greenspoint Pk. Dr.
Suite 300, South Atrium
City/State/Zip Houston, TX 77060

Purchaser N/A

Operator Contact Person Carole Favro
Phone (713) 874-9877

Contractor: License #
Name

Wellsite Geologist
Phone

Designate Type of Completion
 New Well Re-Entry Workover
 Oil SWD Temp Abd
 Gas Inj Delayed Comp.
 Dry Other (Core, Water Supply etc.)

If OWWO: old well info as follows:
 Operator Tenneco Oil Company
 Well Name Tallman #3-17
 Comp. Date Old Total Depth 4956'

WELL HISTORY

Drilling Method:
 Mud Rotary Air Rotary Cable

1-31-86	2-13-86	2-14-86
Spud Date	Date Reached TD	Completion Date
4956'	4956'	date to SWD:
Total Depth	PBTD	Unknown

Amount of Surface Pipe Set and Cemented at 323 feet
 Multiple Stage Cementing Collar Used? Yes No
 If yes, show depth set.....feet
 If alternate 2 completion, cement circulated from 323 feet depth to Surface/.110 SX cmt
 Cement Company Name
 Invoice #

API NO. 15-191-21904
 County Sumner

SW NE NE Sec. 17 Twp 32S Rge. 2 East X West

4290 Ft North from Southeast Corner of Section
 990 Ft West from Southeast Corner of Section
 (Note: Locate well in section plat below)


Lease Name Tallman Well # 3-17

Field Name Oxford West

Injection Rock & Krg Formation Arbuckle Dolomite & Granite Wash

Elevation: Ground 1242 KB 1248

Section Plat

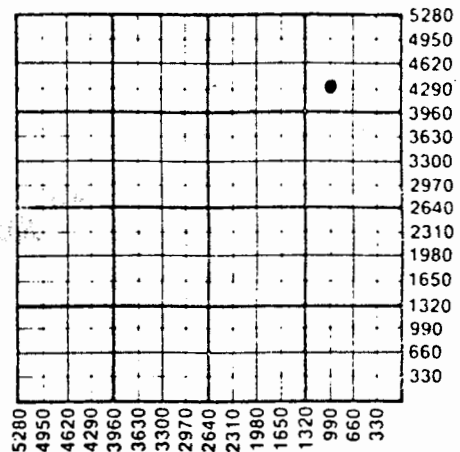

JAN 26 1988

WATER SUPPLY INFORMATION

Disposition of Produced Water: Disposal
 Docket # Repressuring

Questions on this portion of the ACO-1 call:

Water Resources Board (913) 296-3717

Source of Water:
 Division of Water Resources Permit #

Groundwater.....Ft North from Southeast Corner
 (Well)Ft West from Southeast Corner of
 Sec Twp Rge East West

Surface Water.....Ft North from Southeast Corner
 (Stream, pond etc).....Ft West from Southeast Corner
 Sec Twp Rge East West

Other (explain).....
 (purchased from city, R.W.D. #)

INSTRUCTIONS: This form shall be completed in triplicate and filed with the Kansas Corporation Commission, 200 Colorado Derby Building, Wichita, Kansas 67202, within 120 days of the spud date of any well. Rule 82-3-130, 82-3-107 and 82-3-106 apply.

Information on side two of this form will be held confidential for a period of 12 months if requested in writing and submitted with the form. See rule 82-3-107 for confidentiality in excess of 12 months.

30-68-11

SIDE TWO

Operator Name CITATION OIL & GAS CORP. Lease Name..... Tallman Well #.. 3-17..

Sec..... 17.. Twp.... 325.. Rge.... 2..... East West County..... Sumner

WELL LOG

INSTRUCTIONS: Show important tops and base of formations penetrated. Detail all cores. Report all drill stem tests giving interval tested, time tool open and closed, flowing and shut-in pressures, whether shut-in pressure reached static level, hydrostatic pressures, bottom hole temperature, fluid recovery, and flow rates if gas to surface during test. Attach extra sheet if more space is needed. Attach copy of log.

Drill Stem Tests Taken Yes No
 Samples Sent to Geological Survey Yes No
 Cores Taken Yes No

Formation Description
 Log Sample

Name	Top	Bottom
Kansas City	2818	
Mississippi	3428	
Kenderhook	3701	
Simpson	3758	
Arbuckle	3799	
Granite Wash	4876	

REMARKS: PLEASE NOTE THIS WELL WAS PURCHASED FROM TENNECO OIL CO. ON 10-22-87, EFFECTIVE 8-1-87. WELL FILE RECORDS ARE VERY INCOMPLETE. COMPLETED AS SWD WELL, DISPOSING INTO OPEN HOLE IN ARBUCKLE DOLOMITE 3799-4876' AND GRANITE WASH 4876-4955', THRU 2-7/8" TBG SET AT 3694'.

CASING RECORD <input checked="" type="checkbox"/> New <input type="checkbox"/> Used							
Report all strings set-conductor, surface, intermediate, production, etc.							
Purpose of String	Size Hole Drilled	Size Casing Set (in O.D.)	Weight Lbs/Ft.	Setting Depth	Type of Cement	#Sacks Used	Type and Percent Additives
Surface	12-1/4"	8-5/8"	24	323	cl. "H"	110	3% cc
Production	7-7/8"	5-1/2"	15.5	3896	EA-2	270	2% KCL

PERFORATION RECORD		Acid, Fracture, Shot, Cement Squeeze Record	
Shots Per Foot	Specify Footage of Each Interval Perforated	(Amount and Kind of Material Used)	Depth
.....
.....
.....
.....

TUBING RECORD	Size	Set At	Packer at	Liner Run	<input type="checkbox"/> Yes <input type="checkbox"/> No
.....