

R 21E  
R 22E

R 22E  
R 23E


R 23E  
R 24E

# CRAWFORD

Cherokee

31  
32

32  
33

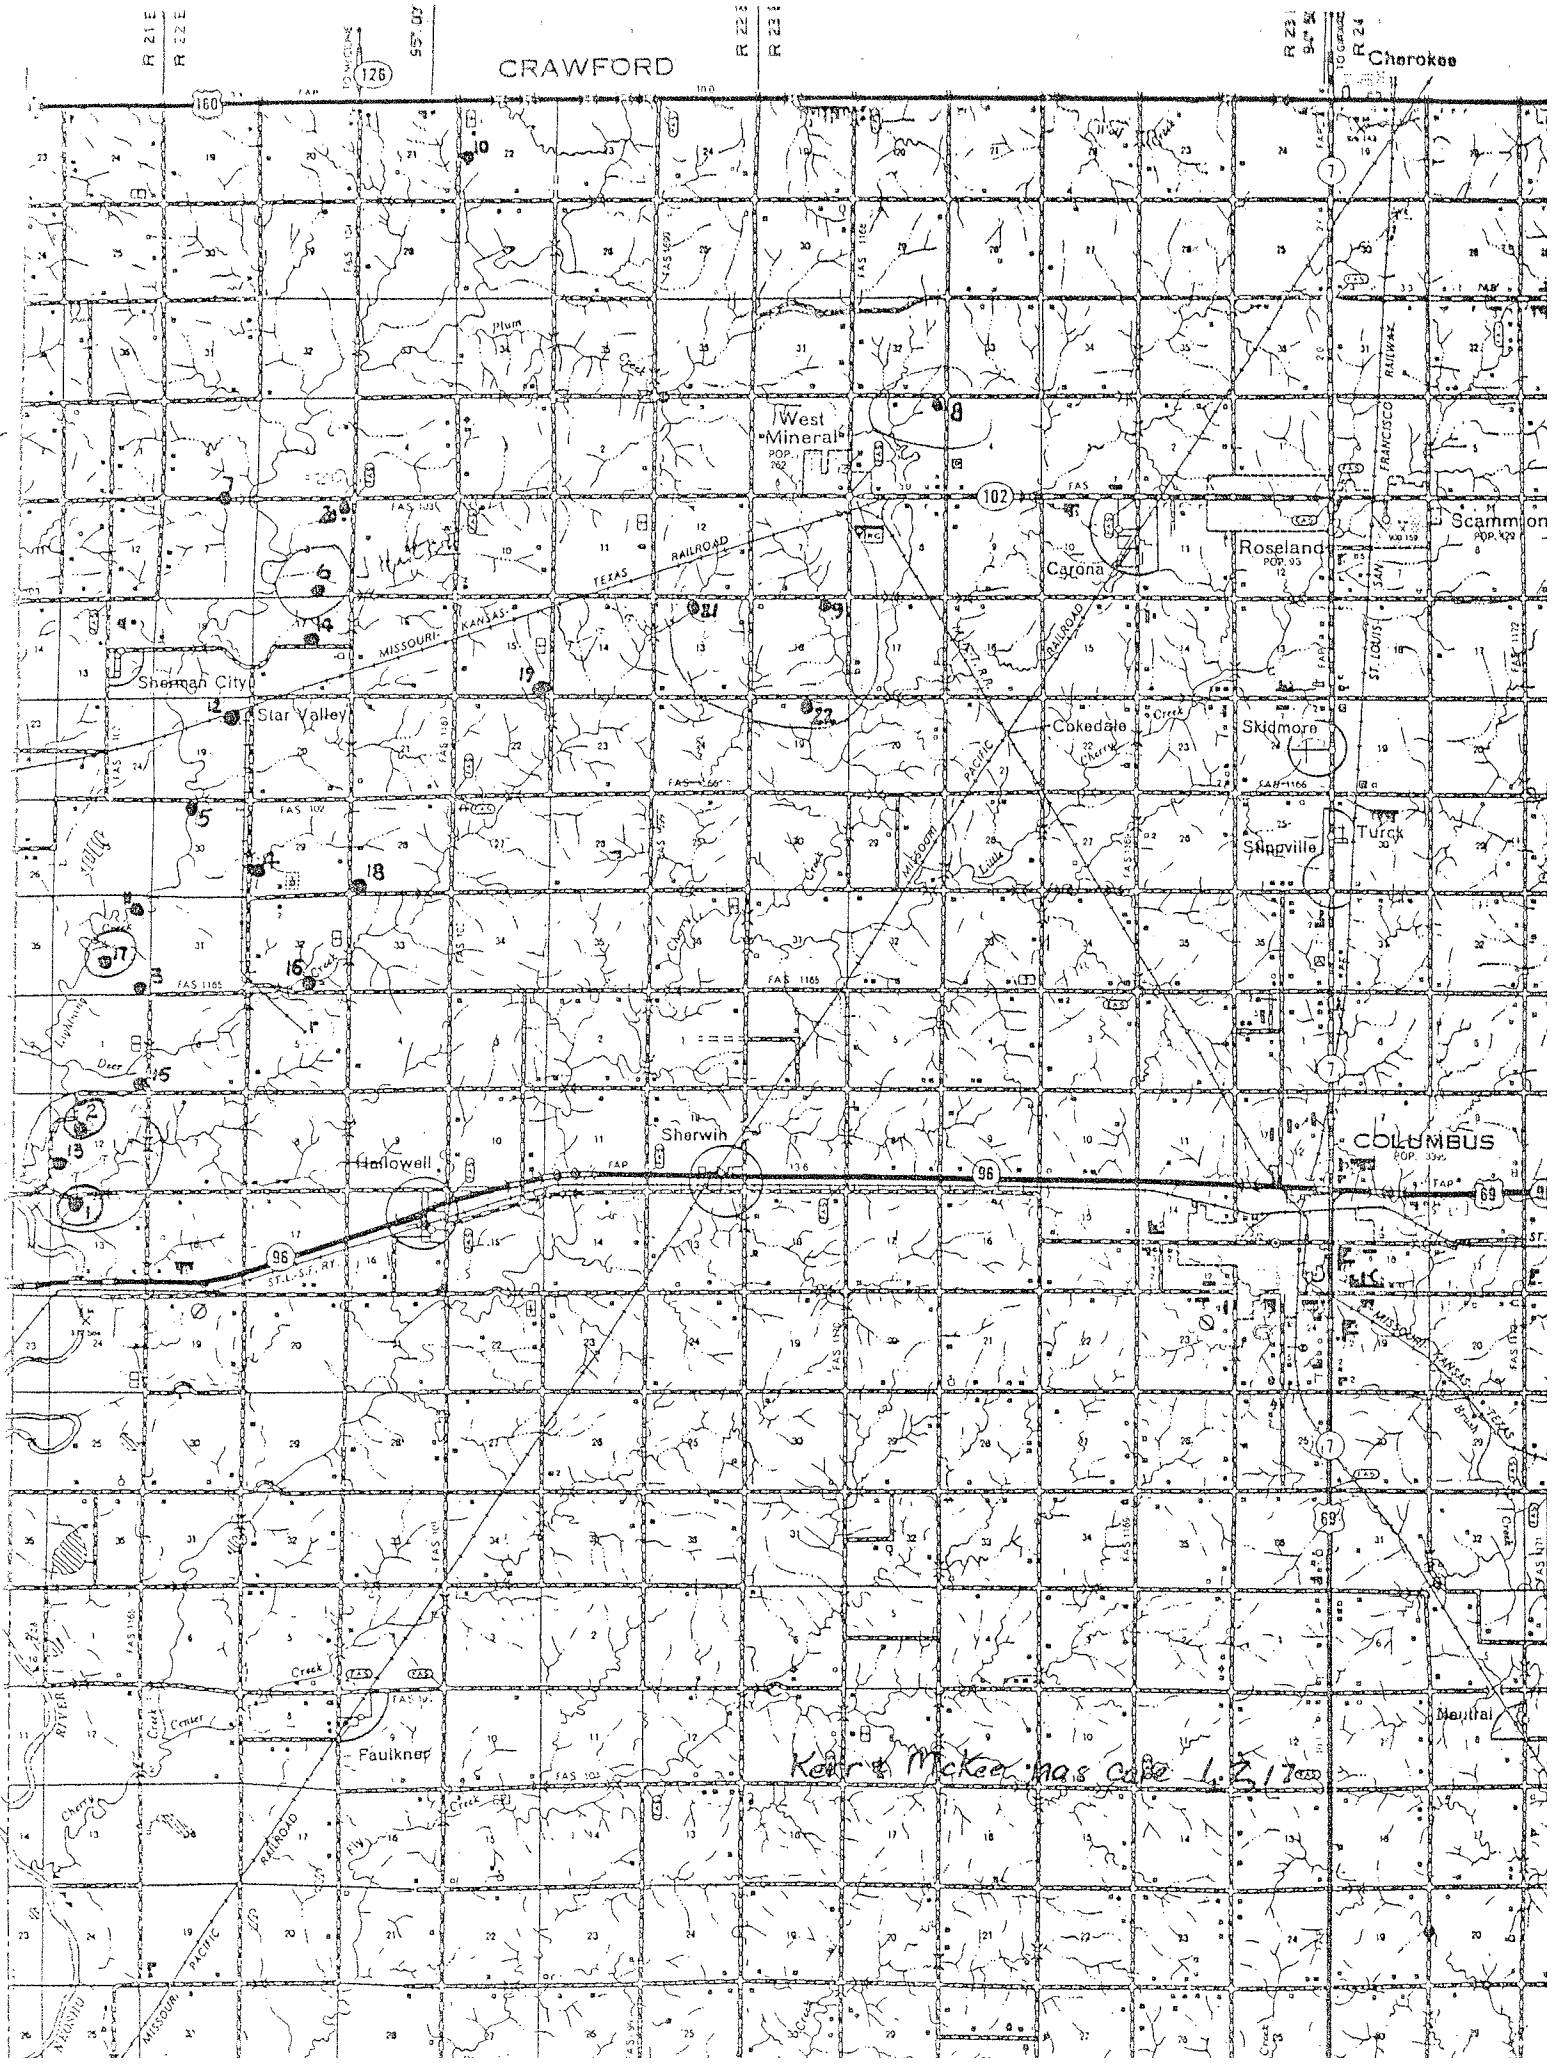

County	ID No.	Qua	Qua	Qua	Sec.	Twn	Rng	Elev.	TopC	TD	#Bxs
CHEROKEE	PM 08				5	32 S	23 E	905	384	661	28
CHEROKEE	PM 08T				5	32 S	23 E	905	300	525	22
CHEROKEE	PM 12	SW	NE	NE	19	32 S	22 E	830	437	775	35
LABETTE	PM 13	NW	SW	NW	12	33 S	21 E	810	434	745	21
CHEROKEE	PM 16	SW	SW	SE	32	32 S	22 E	835	390	638	26
LABETTE	PM 17	NW	SW	NW	36	32 S	21 E	830	403	735	35
CHEROKEE	PM 18	SW	SW	SW	28	32 S	22 E	850	409	758	35
CHEROKEE	PM 20	SW	NE	NE	8	32 S	22 E	895	492	847	36
CHEROKEE	PM 21	NE	NE	NW	12	32 S	22 E	880	391	735	36
CHEROKEE	PM 22				19	32 S	23 E	890	380	722	33

307 6000