

Map No. 100 Sec. 24 Twp. 32 R. 4

Well No. 6 Shannon Farm

Gypsy Oil _____ Company

NORTH


SOUTH

Location

Drilling Remarks

Rig Up

Drilling Remarks

RECORD

Cased _____ in. _____ ft.

Sand

Gas

Oil

Total Depth_____

PRODUCTION

1st 24 hrs. Nat.-----

1st. 24 hrs. after shot_____

Gas _____ cu. ft.

Dry Hole

Abandoned

Map No. Kansas Sec. 24 Twp. 32 R. 4


Well No. 6 Shannon Farm
Gypsy Oil Company

990 Ft. from N. Line

_____ Ft. from S. Line

330 Ft. from E. Line

_____ Ft. from W. Line

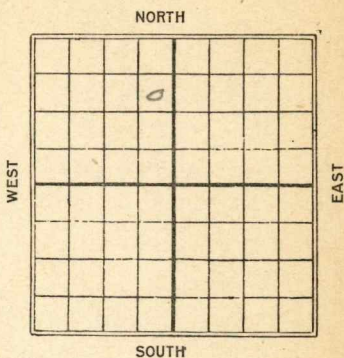

1st + Comp

Date	REPORT
<u>1925</u>	
<u>3/30</u>	<u>2971-3034 160 gts</u>
	<u>100 Bbls</u>

Map No. **KANSAS** Sec. 24 Twp. 32 R. 4

Well No. 6 Shannon

Gypsy Oil Company

Contractor


COMPLETED SECTION PLAT

990 Ft. from N. Line

Ft. from S. Line

330 Ft. from E. Line

Ft. from W. Line

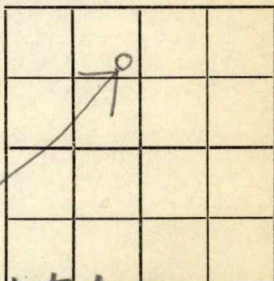

Locate 1/2 + Completed

Location

Rig up

Drilling and Remarks:

160/100 ftk

RECORD

Cased _____ in., _____ ft.

Sand 2971-3034

Gas _____

Oil _____

Total Depth _____

PRODUCTION

1st 24 hrs. Nat. _____

1st 24 hrs. after shot _____

Gas _____ Cu. Ft.

Dry Hole _____

Abandoned _____


Date

3/30 1926

M. A. BENEAR

Scout

Please locate location
 of this well please
 don't know which
 quarter it is in
 Sam

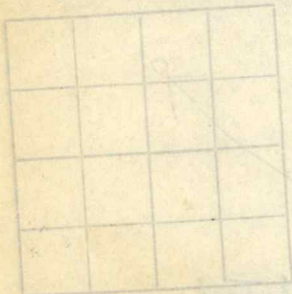

Fl. from N. Line

Fl. from S. Line

Fl. from E. Line

Fl. from W. Line

RECORD

Cased in
 Sand
 Gas
 Oil

Location

Rig up

Drilling and Remarks:

Returned
 Cards *SPS*
 Tracing *Rm*
 France Map *Rm*
 Scarborough Map *B*
 Moody Map
 Scarborough Plat Book
 Moody Plat Book

Date