


Map No. *K* Sec. *24* Twp. *32* R. *4*

Well No. *10 Shannon* Farm

*Gypsy Oil Co.* Company

NORTH

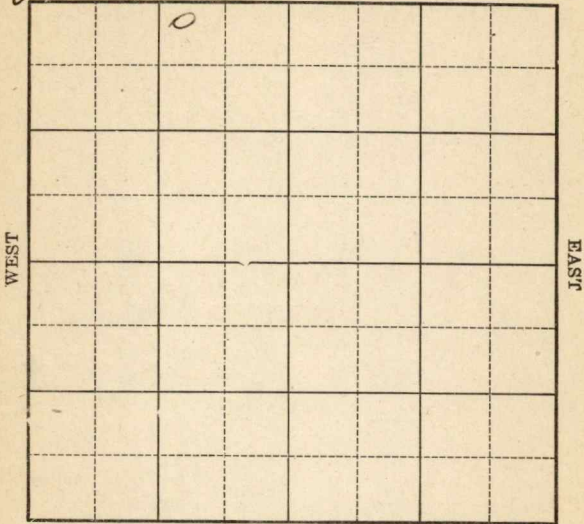

Location \_\_\_\_\_

Drilling Remarks \_\_\_\_\_  
\_\_\_\_\_  
\_\_\_\_\_  
Rig Up \_\_\_\_\_

Drilling Remarks \_\_\_\_\_  
\_\_\_\_\_  
\_\_\_\_\_  
**RECORD**

Cased \_\_\_\_\_ in. \_\_\_\_\_ ft.

Sand \_\_\_\_\_

Gas \_\_\_\_\_

Oil \_\_\_\_\_

Total Depth \_\_\_\_\_

**PRODUCTION**

1st 24 hrs. Nat. \_\_\_\_\_

1st 24 hrs. after shot \_\_\_\_\_

Gas \_\_\_\_\_ cu. ft.

Dry Hole \_\_\_\_\_

Abandoned \_\_\_\_\_

*Cowley*

Map No. *Kansas* Sec. *24* Twp. *32* R. *4*

Well No. *10 Shannon* Farm


*Gypsy Oil* Company

*250* Ft. from N. Line

..... Ft. from S. Line

*1070* Ft. from E. Line

..... Ft. from W. Line

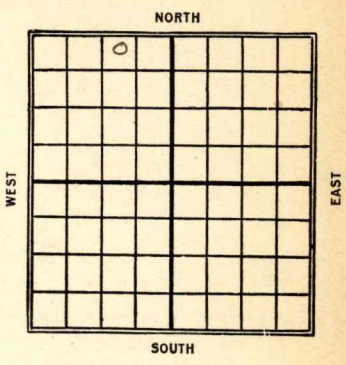

Date	REPORT
<i>1926</i>	
<i>6/2</i>	<i>R.O.G.</i>
<i>6/10</i>	<i>Rig</i>
<i>6/18</i>	<i>Rigging up</i>
<i>6/25</i>	<i>Spudding</i>
<i>6/30</i>	<i>Shl 775</i>
<i>7/8</i>	<i>" 1660</i>
<i>7/15</i>	<i>" 2010</i>
<i>7/22</i>	<i>" 2215</i>
<i>7/28</i>	<i>" 2425</i>
<i>8/4</i>	<i>" 2640</i>
<i>8/18</i>	<i>Pay 2998-3005</i>
	<i>sand 2990-3019</i>
	<i>90 bbls natural</i>
	<i>T.D. 3019</i>

*K2* KANSAS Sec. *24* Twp. *32* R. *4*  
 Well No. *10 Shannon*  
 Contractor

FIRST REPORTS

SECTION PLAT

*250* Ft. from N. Line  
 Ft. from S. Line  
*1070* Ft. from E. Line  
 Ft. from W. Line

	<i>0</i>		

Location \_\_\_\_\_  
 Rig up \_\_\_\_\_  
 Drilling and Remarks:

*ROF*

RECORD

Cased \_\_\_\_\_ in., \_\_\_\_\_ ft.  
 Sand \_\_\_\_\_  
 Gas \_\_\_\_\_  
 Oil \_\_\_\_\_  
 Total Depth \_\_\_\_\_

PRODUCTION

1st 24 hrs. Nat. \_\_\_\_\_  
 1st 24 hrs. after shot \_\_\_\_\_  
 Gas \_\_\_\_\_ Cu. Ft.  
 Dry Hole \_\_\_\_\_  
 Abandoned \_\_\_\_\_

Date

JUN 2 1926

CHAS. L. SHERWOOD

192

Scout

Cowley

Map No. 2 KANSAS Sec. 24 Twp. 32 R. 4

Well No. 10 Shannon


Company

Contractor

COMPLETED

SECTION PLAT

250 Ft. from N. Line

\_\_\_\_\_ Ft. from S. Line

1070 Ft. from E. Line

\_\_\_\_\_ Ft. from W. Line

	o		

Location \_\_\_\_\_

Rig up \_\_\_\_\_

Drilling and Remarks:

Key 2998-3005

90 lbs natural

RECORD

Cased \_\_\_\_\_ in., \_\_\_\_\_ ft.

Sand 2990-3019

Gas \_\_\_\_\_

Oil \_\_\_\_\_

Total Depth 3019

PRODUCTION

1st 24 hrs. Nat. \_\_\_\_\_

1st 24 hrs. after shot. \_\_\_\_\_

Gas \_\_\_\_\_ Cu. Ft.

Dry Hole \_\_\_\_\_

Abandoned \_\_\_\_\_

Date

AUG 18 1926

CHAS. L. SHERWOOD

192

Scout