


Kansas *Cowley Co*

Map No. _____ Sec. *24* Twp. *32* R. *4*

Well No. *9 Shannon* Farm _____

Gypsy Oil Company _____

NORTH

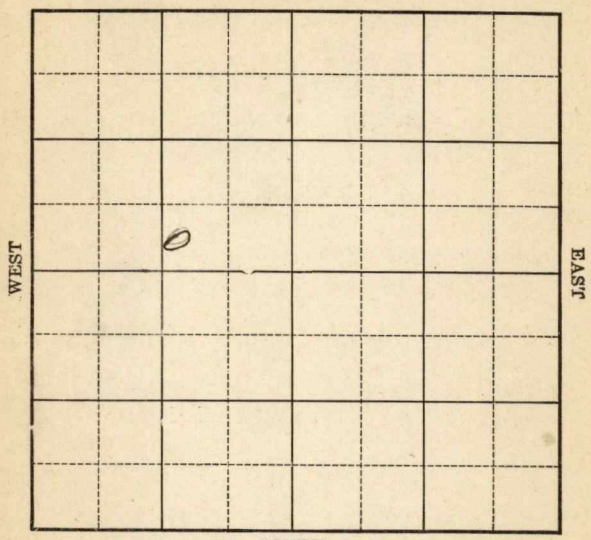

Location _____

Rig Up _____

Drilling Remarks _____

Drilling Remarks _____

RECORD

PRODUCTION

Cased _____ in. _____ ft.

1st 24 hrs. Nat. _____

Sand _____

1st 24 hrs. after shot _____

Gas _____

Gas _____ cu. ft.

Oil _____

Dry Hole _____

Total Depth _____

Abandoned _____

Cowley

K2 Map No. **KANSAS** Sec. *24* Twp. *32* R. *4*

Well No. *9 Shannon*

Gypsy Oil Co. Company

Contractor

FIRST REPORTS

SECTION PLAT

----- Ft. from N. Line

405 Ft. from S. Line

990 Ft. from E. Line

----- Ft. from W. Line

Swir to #4

Location -----

Rig up

Drilling and Remarks:

RECORD

Cased ----- in., ----- ft.

Sand -----

Gas -----

Oil -----

Total Depth -----

PRODUCTION

1st 24 hrs. Nat. -----

1st 24 hrs. after shot -----

Gas ----- Cu. Ft.

Dry Hole -----

Abandoned -----

Date

MAR 11 1926

CHAS. L. SHERWOOD

192

Scout

Cowley

Map No. **K2 KANSAS** Sec. *24* Twp. *32* R. *4*

Well No. *9 Shannon*
Supply Oil Co Company

Contractor

COMPLETED


SECTION PLAT

----- Ft. from N. Line

405 Ft. from S. Line

990 Ft. from E. Line

----- Ft. from W. Line

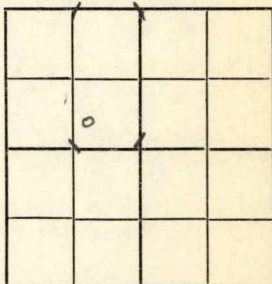

Turn to #4

Location -----

Rig up -----

Drilling and Remarks:

oil 2320-2333'

1209 135 lbs.

RECORD

Cased _____ in., _____ ft.

Sand *2309-2349*

Gas -----

Oil -----

Total Depth *2349*

PRODUCTION

1st 24 hrs. Nat. -----

1st 24 hrs. after shot. -----

Gas ----- Cu. Ft.

Dry Hole -----

Abandoned -----

Date

MAY 12 1926

----- 192-----

CHAS. L. SHERWOOD

----- Scout