


Section 24 Township 32 Range 4-E

Well No. #4 Wallace

Company H. H. Blair

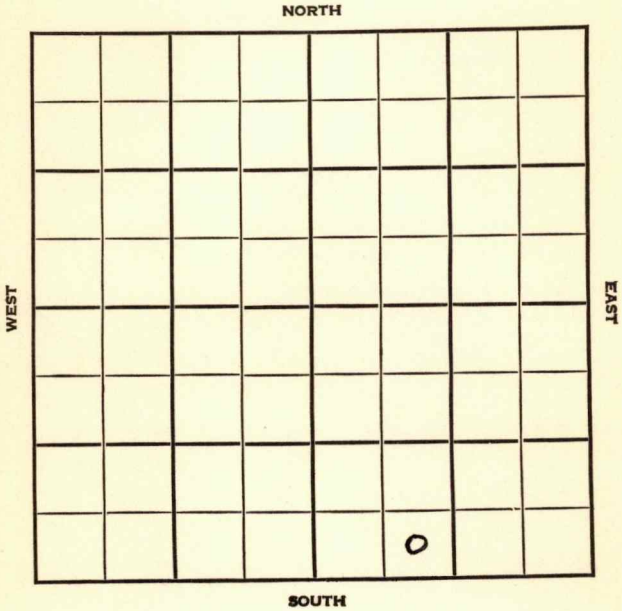

**KANSAS**

Cowley

Sec. 24 Twp. 32 R. 4E

Well No. #4 Wallace Farm

H. H. Blair Company


Miscellaneous

\_\_\_\_\_ Ft. from N. Line

330' Ft. from S. Line

\_\_\_\_\_ Ft. from E. Line

990' Ft. from W. Line

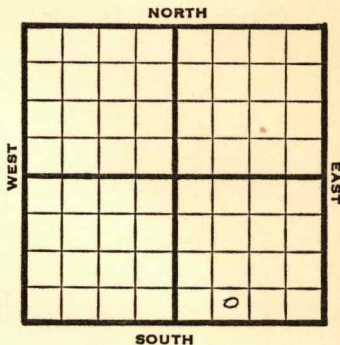

SE SW SE

1948

**E1 1245'**

REPORT

5/12

15" @ 10'  
Drlg. 1005'

5/19

**Hoover 1726'**  
TD 1737'

5/26

Drlg. 2337'

6/1

Drlg. 2490'

6/9

**Bart 3010'**  
TD 3042'  
5" @ 3013'

6/16

TD 3042'  
**Bart 3010'**  
5"@ 3013'  
Pump 20 Oil / 20W Pot  
380 Gr.  
Comp

**COMPLETED**

Map No. \_\_\_\_\_ Sec. 24 Twp. 32 R. 4E

Well No. 4 Wallace

H. H. Blair Company

**FIRST REPORT**

Contractor

SE SW SE

SECTION PLAT

			o

\_\_\_\_\_ Ft. from N. Line

330 Ft. from S. Line

\_\_\_\_\_ Ft. from E. Line

990 Ft. from W. Line

Cowley County

Location \_\_\_\_\_

Rig up \_\_\_\_\_

Drilling and Remarks:

15" @ 10'

drlg. 1005

RECORD

Cased \_\_\_\_\_ in., \_\_\_\_\_ ft.

Sand \_\_\_\_\_

Gas \_\_\_\_\_

Oil \_\_\_\_\_

Total Depth \_\_\_\_\_

PRODUCTION

1st 24 hrs. Nat. \_\_\_\_\_

1st 24 hrs. after shot \_\_\_\_\_

Gas \_\_\_\_\_ Cu. Ft.

Dry Hole \_\_\_\_\_

Abandoned \_\_\_\_\_

Date

MAY 12 1948

19

S. J. LEWIS

Scout

Map No. 2 Sec. 24 Twp. 32 R. 4E

Well No. 4 Wallace

H. H. Blair Company

**COMPLETE**

Contractor

SE SW SE

B<sup>7</sup> 1245  
SECTION PLAT


         Ft. from N. Line

330 Ft. from S. Line

         Ft. from E. Line

990 Ft. from W. Line

Cowley County

Location         

Rig up         

Drilling and Remarks:

Bar 73010  
5' @ 3018  
Pump 20 oil + 20W  
PJ

8882

**RECORD**

Cased          in.,          ft.

Sand         

Gas         

Oil          ✓

Total Depth 8042

**PRODUCTION**

1st 24 hrs. Nat.         

1st 24 hrs. after shot         

Gas          Cu. Ft.

Dry Hole         

Abandoned         

Date

JUN 16 1948

19

S. J. LEWIS

Scout