


Map No. Kansas Sec. 24 Twp. 32 R. 4
 Well No. H Wallace Farm
Mc Knab Company

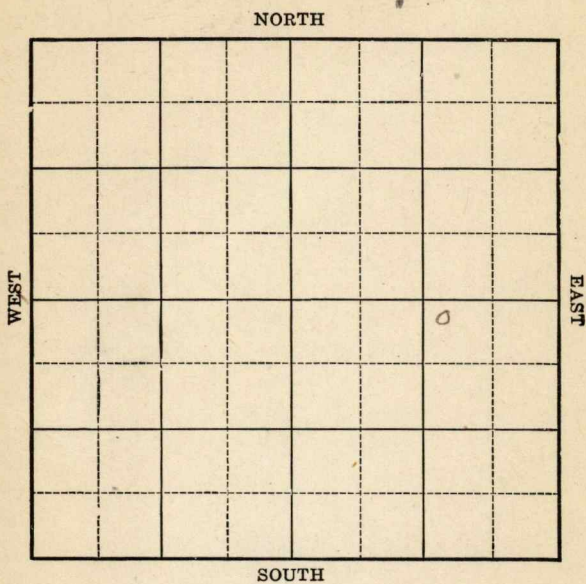

Location _____
 Drilling Remarks _____

Rig Up _____
 Drilling Remarks _____

RECORD

Cased _____ in. _____ ft.
 Sand _____
 Gas _____
 Oil _____
 Total Depth _____

PRODUCTION

1st 24 hrs. Nat. _____
 1st. 24 hrs. after shot _____
 Gas _____ cu. ft.
 Dry Hole _____
 Abandoned _____

Map No. Kans Sec. 24 Twp. 32 R. 4

Well No. 4 Wallace Farm


Mc Knab Company

200 Ft. from N. Line

_____ Ft. from S. Line

_____ Ft. from E. Line

1120 Ft. from W. Line

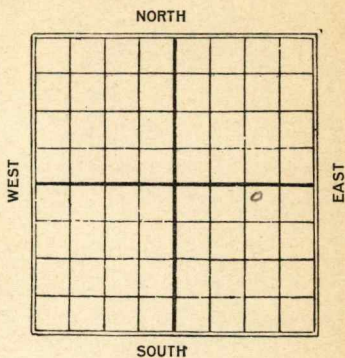

Date	REPORT
1925	
1/24	Sand 1460-75
	30 gals 75 Bbls

Map No. KANSAS Sec. 24 Twp. 32 R. 4

Well No. 4 Wallace

M^o Lumb Company

FIRST REPORT Contractor

COMPLETED

SECTION PLAT

200 Ft. from N. Line

----- Ft. from S. Line

----- Ft. from E. Line

1120 Ft. from W. Line

			0

Location -----

Rig up -----

Drilling and Remarks:

0. 1460-75

30/75 lbs

RECORD

Cased ----- in., ----- ft.

Sand -----

Gas -----

Oil -----

Total Depth -----

PRODUCTION

1st 24 hrs. Nat. -----

1st 24 hrs. after shot -----

Gas ----- Cu. Ft.

Dry Hole -----

Abandoned -----

Date

M. A. BENEAR

1124 192 5 Scout