


Map No. Kansas Sec. 24 Twp. 32 R. 4
 Well No. 7 Wallace Farm _____
J. A. Hull Company _____

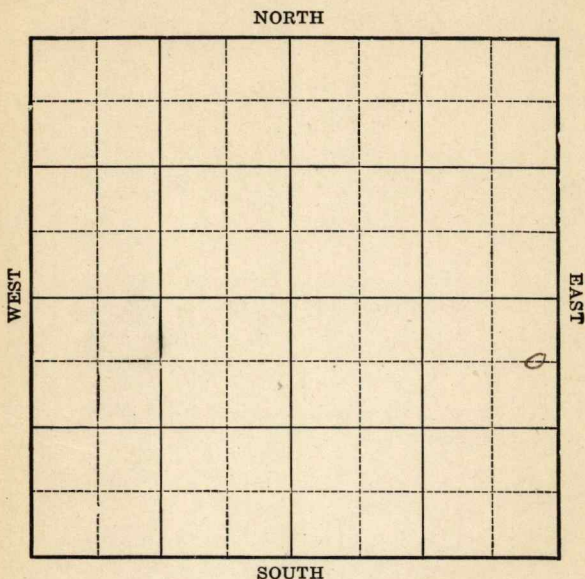

Location _____

Drilling Remarks _____

RECORD

Cased _____ in. _____ ft.

Sand _____

Gas _____

Oil _____

Total Depth _____

Rig Up _____

Drilling Remarks _____

PRODUCTION

1st 24 hrs. Nat. _____

1st. 24 hrs. after shot _____

Gas _____ cu. ft.

Dry Hole _____

Abandoned _____

MAP NO. K2 **KANSAS** SEC. 24 TWP. 32S R. 4E

WELL NO. 7 Helfelder
Hull Oil COMPANY _____

CONTRACTOR _____

SECTION PLAT

ABANDONED

_____ FT. FROM N. LINE
_____ FT. FROM S. LINE
_____ FT. FROM E. LINE
_____ FT. FROM W. LINE

LOCATION _____

RIG UP _____

DRILLING AND REMARKS:

*see down
about on
location
of well*

RECORD

CASED _____ IN. _____ FT.
SAND _____
GAS _____
OIL _____
TOTAL DEPTH 2379

PRODUCTION

1ST 24 HRS. NAT. _____
1ST 24 HRS. AFTER SHOT _____
GAS _____ CU. FT.
DRY HOLE ✓
ABANDONED ✓

DATE

7/10 192 2 SCOUT

Map No. **KANSAS** Sec. 24 Twp. 32 R. 4Well No. 7 WallaceJ. A. Hull Company

FIRST REPORT

Contractor

ABANDONED

SECTION PLAT

660 Ft. from N. Line

_____ Ft. from S. Line

200 Ft. from E. Line

_____ Ft. from W. Line

			8

Location _____

Rig up _____

Drilling and Remarks:

20 + 9 2379'

RECORD

Cased _____ in., _____ ft.

Sand _____

Gas _____

Oil _____

Total Depth _____

PRODUCTION

1st 24 hrs. Nat. _____

1st 24 hrs. after shot _____

Gas _____ Cu. Ft.

Dry Hole _____

Abandoned _____

Date

1/24 1925

M. A. BENEAR

_____ Scout