


Map No. Kansas Sec. 24 Twp. 32 R. 4

Well No. 6 Wallace Farm _____
J. A. Hull Company _____

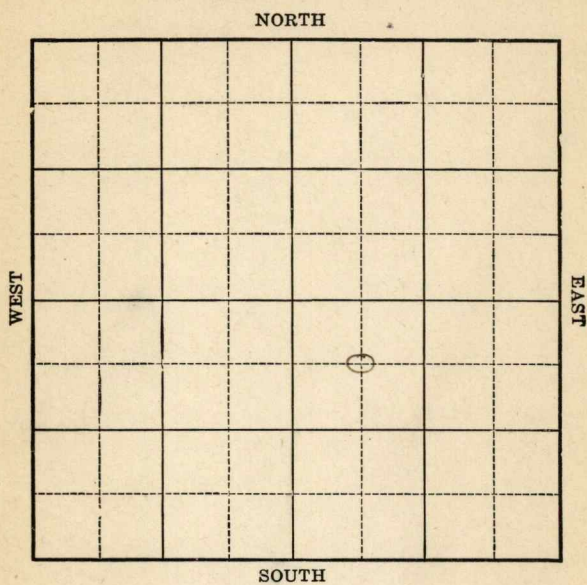

Location _____
Drilling Remarks _____

Rig Up _____
Drilling Remarks _____

RECORD

Cased _____ in. _____ ft.

Sand _____

Gas _____

Oil _____

Total Depth _____

PRODUCTION

1st 24 hrs. Nat. _____

1st. 24 hrs. after shot _____

Gas _____ cu. ft.

Dry Hole _____

Abandoned _____

Map No. Kans Sec. 24 Twp. 32 R 4

Well No. 6 Wallace Farm


J. A. Null Company

660 Ft. from N. Line

..... Ft. from S. Line

..... Ft. from E. Line

660 Ft. from W. Line

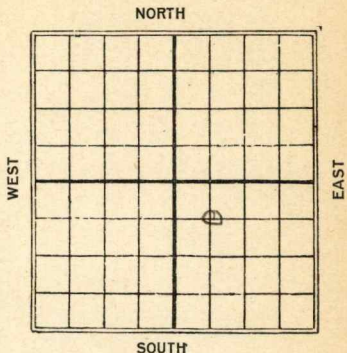

Date

REPORT

1925

1/24

Pay 1477-85

40 qt 10 Bbls

Map No. **KANSAS** Sec. *24* Twp. *32* R. *4*

Well No. *#6 Wallace*

J. A. Hull Company

Now J. A. Hull Contractor

FIRST REPORT

SECTION PLAT

COMPLETED
660 Ft. from N. Line

		•	

----- Ft. from S. Line

----- Ft. from E. Line

660 Ft. from W. Line

Location -----

Rig up -----

Drilling and Remarks:

Pay. 1477-85
40/10 lbs.

RECORD

Cased ----- in., ----- ft.

Sand -----

Gas -----

Oil -----

Total Depth -----

PRODUCTION

1st 24 hrs. Nat. -----

1st 24 hrs. after shot -----

Gas ----- Cu. Ft.

Dry Hole -----

Abandoned -----

Date

1/24 192*5*

M. A. BENEAR

Scout