

Map No. Kans Sec. 24 Twp. 32 R. 4

Well No. 8-Wallace Farm


J. A. Null Company

200 Ft. from N. Line

..... Ft. from S. Line

200 Ft. from E. Line

..... Ft. from W. Line

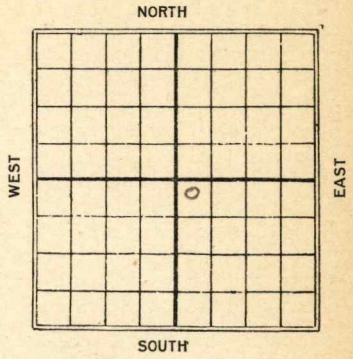

Date
1925

REPORT

1/24

Sand 2334-60
100 gts 50 Bbls
T.D. 2362

Map No. 2 **KANSAS** Sec. 24 Twp. 32 R. 4

Well No. 8-Wallace

J. G. Hull Company

FIRST REPORT Contractor

COMPLETED

SECTION PLAT

200 Ft. from N. Line

_____ Ft. from S. Line

200 Ft. from E. Line

_____ Ft. from W. Line

		●	

Location _____

Rig up _____

Drilling and Remarks:

Sand 2334-60
100/50 bbls
J.D. 2362'

RECORD

Cased _____ in., _____ ft.

Sand _____

Gas _____

Oil _____

Total Depth _____

PRODUCTION

1st 24 hrs. Nat. _____

1st 24 hrs. after shot _____

Gas _____ Cu. Ft.

Dry Hole _____

Abandoned _____

Date

1/24 1925

M. A. BENEAR

Scout